

**ASTM E 1886 and ASTM E 1996
TEST REPORT**

Rendered to:

VEKA INC.

**SERIES/MODEL: Softline 70 mm AD & MD
PRODUCT TYPE: PVC Tilt Turn Window**

**Report No.: 66065.02-109-44
Revision 2: 03/02/07
Test Dates: 06/26/06
Through: 12/05/06
Report Date: 01/24/07
Expiration Date: 12/05/10**

ASTM E 1886 and ASTM E 1996 TEST REPORT

Rendered to:

VEKA INC.
100 Veka Drive
P.O. Box 250
Fombell, Pennsylvania 16123-0250

Report No.: 66065.02-109-44
Revision 2: 03/02/07
Test Dates: 06/26/06
Through: 12/05/06
Report Date: 01/25/07
Expiration Date: 12/05/10

Project Summary: Architectural Testing, Inc. (ATI) was contracted by Veka Inc. to perform testing on a Series/Model Softline 70 mm AD & MD, PVC tilt-turn window. The samples tested met the performance requirements set forth in the referenced test procedures for a ± 50.0 psf Design Pressure with missile impacts corresponding to Missile Level D and Wind Zone 3. Test specimen description and results are reported herein.

Test Procedures: The test specimens were evaluated in accordance with the following:

ASTM E 1886-02, Standard Test Method for Performance of Exterior Windows, Curtain Walls, Doors and Storm Shutters Impacted by Missile(s) and Exposed to Cyclic Pressure Differentials.

ASTM E 1996-02, Standard Specification for Performance of Exterior Windows, Glazed Curtain Walls, Doors and Storm Shutters Impacted by Wind Borne Debris in Hurricanes.

Test Specimen Description:

Series/Model: Softline 70 mm AD & MD

Product Type: PVC Tilt-Turn Window

Overall Size: 1194 mm (47") wide by 1816 mm (71-1/2") high

Vent Size: 1041 mm (41") wide by 1626 mm (64") high

Overall Area: 2.17 m² (23.3 ft²)

Finish: All PVC as white.

Test Specimen Description: (Continued)

Glazing Details: The unit was glazed with 28.5 mm (1-1/8") thick insulating glass fabricated from a sheet of 4 mm (5/32") thick clear annealed glass outboard, a sheet of 14.5 mm (9/16") thick laminated glass inboard and an aluminum spacer system. The laminated glass was comprised of two sheets 6 mm (1/4") thick annealed glass and a 2.5 mm (0.100") thick PVB interlayer. The glass was set from the interior onto a vinyl bulb and secured with PVC glazing beads with a vinyl dual fin vinyl weatherstrip was against the glass.

Weatherstripping:

<u>Description</u>	<u>Quantity</u>	<u>Location</u>
Kerf mounted 6 mm (0.230") high vinyl hollow bulb seal	1 Row	Vent stiles and rails, head, sill jamb and intermediate jamb frames
Kerf mounted 5 mm (0.200") high vinyl hollow bulb seal	1 Row	Vent stiles and rails, head, sill jamb and intermediate jamb glazing leg
Kerf mounted dual fin vinyl bulb seal	1 Row	Glazing bead

Frame Construction: Frame members were constructed of extruded PVC with mitered and welded corners.

Vent Construction: Vent members were constructed of extruded PVC members with mitered and welded corners.

Hardware:

<u>Description</u>	<u>Quantity</u>	<u>Location</u>
Multi-point lock with handle	1	24" from the lock stile bottom rail corner
Locks with adjacent keepers	4	Lock stile, 229 mm (9"), 762 mm (30"), 1295 mm (51") from the bottom
	4	Hinge stile, 229 mm (9"), 559 mm (22"), 940 mm (37"), 1346 mm (53") from the bottom
	2	Top rail, 152 mm (6") and 381 mm (15") from the lock stile corner
	3	Bottom rail, 25 mm (1"), 660 mm (26") and 864 mm (34") from the lock stile corner
		Keepers were secured using three (3) 4 mm (#M4) x 22 mm (7/8") screws

Test Specimen Description: (Continued)

Drainage:

<u>Description</u>	<u>Quantity</u>	<u>Location</u>
32 mm (1-1/4") long by 5 mm (3/16") high weepslot	2	64 mm (2-1/2") from each end of the bottom rail in the glazing channel, draining to the exterior hollow below
32 mm (1-1/4") long by 5 mm (3/16") high weepslot	2	127 mm (5") from each end of the bottom rail, draining the exterior hollow
32 mm (1-1/4") long by 5 mm (3/16") high weepslot	2	Sill, 76 mm (3") from each end, draining the top surface to the exterior center hollow
32 mm (1-1/4") long by 5 mm (3/16") high weepslot	2	Sill, 127 mm (5") from each end on the exterior wall, draining the center hollow

Reinforcement: Custom shaped steel reinforcement (Drawing #113.271.1W/2) and a 32 mm by 10 mm (1-1/4" by 3/8") vinyl reinforcement was utilized in the head, sill, and jambs. All vent stiles and rails utilized a custom shaped steel reinforcement (Drawing #113.292.1W/3). All reinforcing was secured with 4 mm (#M4) x 13 mm (1/2") screw at each end and spaced 305 mm (12") on center.

Installation: Window was installed into a Spruce-Pine-Fir wood buck. The frame was set into the buck and secured using 5 mm (#M5) x 76 mm (3") screws, 152 mm (6") from each end and at midspan of both jambs. The exterior perimeter was sealed with silicone.

Test Results: The following results have been recorded:

ASTM E 1886, *Large Missile Impact*

Conditioning Temperature: 79°F
Missile Weight: 9.40 lbs
Missile Length: 8' 0"
Muzzle Distance from Test Specimen: 17 ft.

Test Unit #1

Impact #1: Missile Velocity: 50.4 fps; orientation within $\pm 5^\circ$ of vertical

Impact Area: Upper right corner of glass

Observations: Missile impacted target area, impacted all lites, no damage to unit

Results: Pass

Test Unit #2

Impact #1: Missile Velocity: 50.4 fps; orientation within $\pm 5^\circ$ of vertical

Impact Area: Lower left corner of glass

Observations: Missile impacted target area, impacted all lites, no damage to unit

Results: Pass

Test Unit #3

Impact #1: Missile Velocity: 50.1 fps; orientation within $\pm 5^\circ$ of vertical

Impact Area: Center of glass

Observations: Missile impacted target area, impacted all lites, no damage to unit

Results: Pass

Note: See ATI Sketch #1 for impact locations.

Test Results: (Continued)

ASTM E 1886, Air Pressure Cycling

Test Unit #1

Design Pressure: ±50.0 psf

POSITIVE PRESSURE

Pressure Range (psf)	Number of Cycles	Average Cycle Time (seconds)	Maximum Deflection at Indicator (inch)		
			#1	#2	#3
10.0 to 25.0	3500	2.11	0.12	0.16	0.14
0.0 to 30.0	300	2.33	0.15	0.19	0.17
25.0 to 40.0	600	2.17	0.20	0.25	0.25
15.0 to 50.0	100	2.27	0.27	0.32	0.32
			Permanent Set		
			0.05	0.06	0.06

NEGATIVE PRESSURE

Pressure Range (psf)	Number of Cycles	Average Cycle Time (seconds)	Maximum Deflection at Indicator (inch)		
			#1	#2	#3
15.0 to 50.0	50	2.26	0.40	0.42	0.45
25.0 to 40.0	1050	2.20	0.35	0.35	0.37
0.0 to 30.0	50	2.37	0.30	0.27	0.31
10.0 to 25.0	3350	2.11	0.28	0.25	0.29
			Permanent Set		
			0.15	0.10	0.16

Observations: *No additional damage to test unit.*

Result: Pass

Note: *See ATI Sketch #2 for indicator locations. Test Specimens #1 and #2 were cycled in a common chamber.*

Test Results: (Continued)

ASTM E 1886, Air Pressure Cycling

Test Unit #2

Design Pressure: ±50.0 psf

POSITIVE PRESSURE

Pressure Range (psf)	Number of Cycles	Average Cycle Time (seconds)	Maximum Deflection at Indicator (inch)		
			#1	#2	#3
10.0 to 25.0	3500	2.11	0.13	0.17	0.17
0.0 to 30.0	300	2.33	0.18	0.20	0.19
25.0 to 40.0	600	2.17	0.25	0.25	0.25
15.0 to 50.0	100	2.27	0.27	0.30	0.29
			Permanent Set		
			0.09	0.08	0.06

NEGATIVE PRESSURE

Pressure Range (psf)	Number of Cycles	Average Cycle Time (seconds)	Maximum Deflection at Indicator (inch)		
			#1	#2	#3
15.0 to 50.0	50	2.26	0.26	0.33	0.33
25.0 to 40.0	1050	2.20	0.25	0.32	0.31
0.0 to 30.0	50	2.37	0.21	0.25	0.25
10.0 to 25.0	3350	2.11	0.20	0.24	0.24
			Permanent Set		
			0.10	0.14	0.11

Observations: *No additional damage to test unit.*

Result: Pass

Note: *See ATI Sketch #2 for indicator locations. Test Specimens #1 and #2 were cycled in a common chamber.*

Test Results: (Continued)

ASTM E 1886, Air Pressure Cycling

Test Unit #3

Design Pressure: ±50.0 psf

POSITIVE PRESSURE

Pressure Range (psf)	Number of Cycles	Average Cycle Time (seconds)	Maximum Deflection at Indicator (inch)		
			#1	#2	#3
10.0 to 25.0	3500	1.48	0.06	0.15	0.03
0.0 to 30.0	300	1.82	0.06	0.15	0.04
25.0 to 40.0	600	1.50	0.09	0.19	0.08
15.0 to 50.0	100	2.28	0.11	0.25	0.10
			Permanent Set		
			0.00	0.01	0.01

NEGATIVE PRESSURE

Pressure Range (psf)	Number of Cycles	Average Cycle Time (seconds)	Maximum Deflection at Indicator (inch)		
			#1	#2	#3
15.0 to 50.0	50	1.96	0.10	0.29	0.15
25.0 to 40.0	1050	1.21	0.09	0.21	0.10
0.0 to 30.0	50	1.83	0.06	0.13	0.05
10.0 to 25.0	3350	1.39	0.03	0.09	0.04
			Permanent Set		
			0.2	0.04	0.01

Observations: *No additional damage to test unit.*

Result: Pass

Note: *See ATI Sketch #2 for indicator locations.*

General Note: Upon completion of testing, the specimens met the requirements of Section 7 of ASTM E 1996.

Test Equipment:

Cannon: Constructed from steel piping utilizing compressed air to propel the missile(s)

Missile(s): 2x4 Southern Pine

Timing Device: Electronic Beam Type

Cycling Mechanism: Computer controlled centrifugal blower with electronic pressure measuring device

Deflection Measuring Device: Linear transducers

Tape and film were used to seal against air leakage during structural testing. In our opinion, the tape and film did not influence the results of the test.

Drawing Reference: The following drawings have been checked by Architectural Testing, Inc., and are representative of the samples tested.

Detailed drawings, representative samples of the test specimen and a copy of this report will be retained by Architectural Testing, Inc. for a period of four years from the original test date. This report is the exclusive property of the client so named herein and is applicable to the sample tested. Results obtained are tested values and do not constitute an opinion or endorsement by this laboratory. This report may not be reproduced, except in full, without the approval of Architectural Testing, Inc.

For ARCHITECTURAL TESTING, INC.

Aaron M. Shultz
Technician

Michael D. Stremmel, P.E.
Senior Project Engineer

AMS:vlm/tla

Attachments (pages): This report is complete only when all attachments listed are included.

Appendix-A: ATI Sketches (2)

Appendix-B: Drawings (12)


Revision Log

<u>Rev. #</u>	<u>Date</u>	<u>Page(s)</u>	<u>Revision(s)</u>
0	01/25/07	N/A	Original report issue
1	01/31/07	Summary Page and Page 1	Changed Series/Model from Softline 70 mm to Softline 70 mm AD & MD
2	03/02/07	Page 8 and Appendix B	Added correct drawings to report.


Appendix A

Sketches


REV	DATE	DESCRIPTION	BY

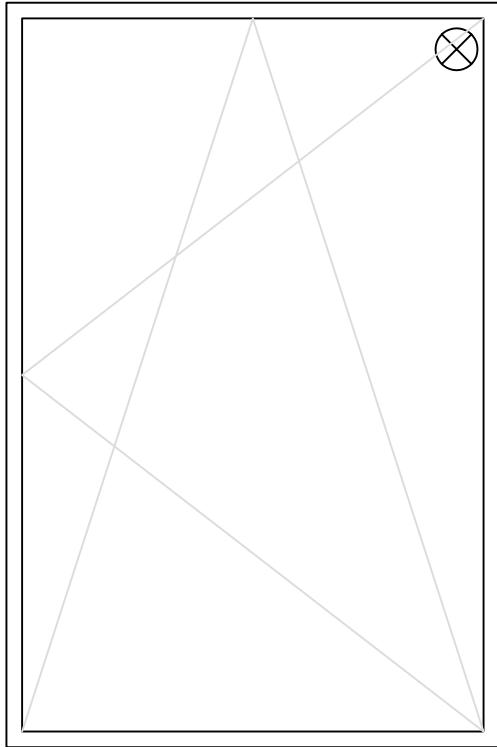

Test Specimen #1

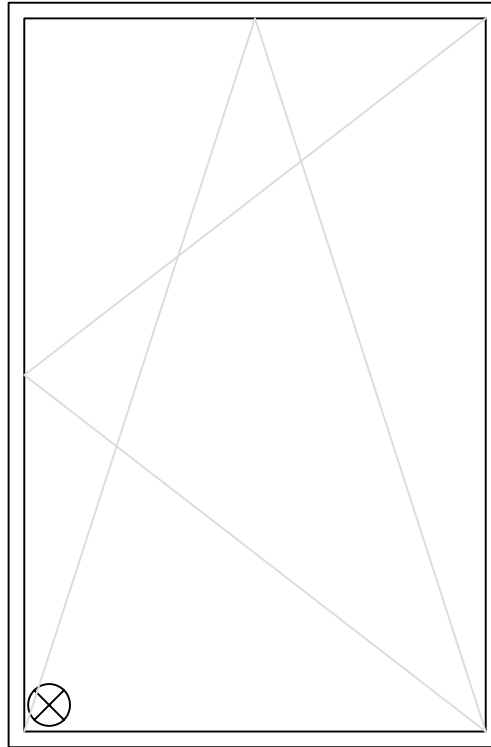


Test Specimen #2

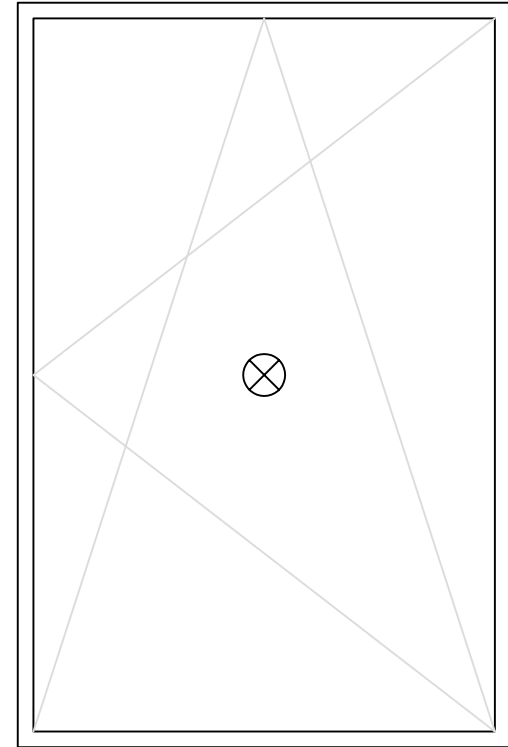

Test Specimen #3

⊗ - Denotes Impact Location

REV	DATE	DESCRIPTION	BY

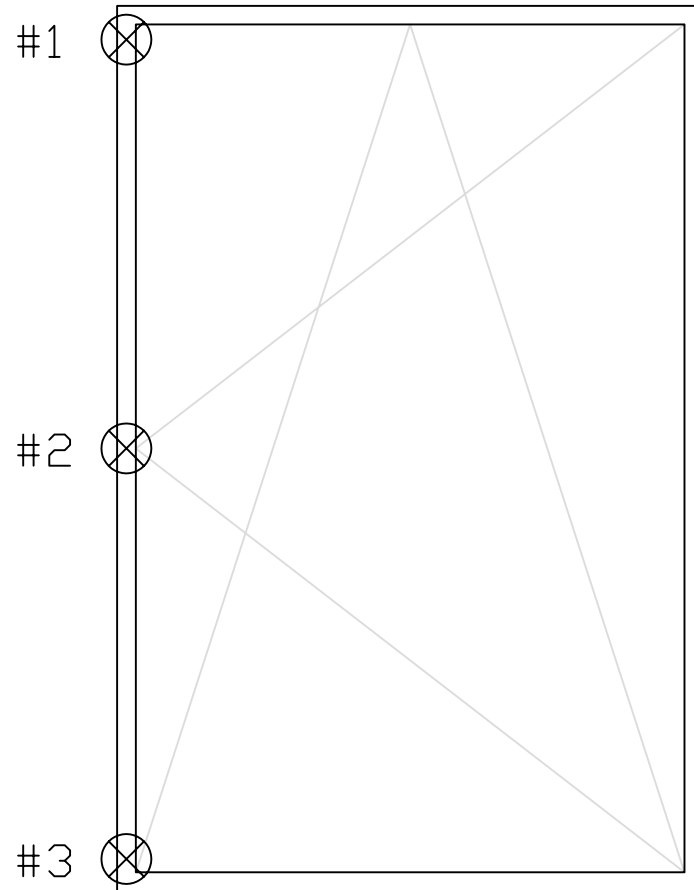

⊗ - Denotes Indicator Location

PROJECT NO.
66065.01
109-44

PROJECT NAME: 70mm Tilt-Turn Window
CLIENT: Veka, Inc.



DRAWING
Sketch #2 - Indicator Locations

DWG. BY:
MDS
DATE:
1/25/07

SHEET
1 OF
1


Appendix B

Drawings

Roto NTS System Veka

12/20-13 AD/MD

Ausführung A500P / SG 3000 / SG 4000

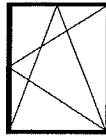


Architectural Testing

Test sample complies with these details.
Deviations are noted.

Report# 66065.02-109-114






Date 3/10/07 Tech AS

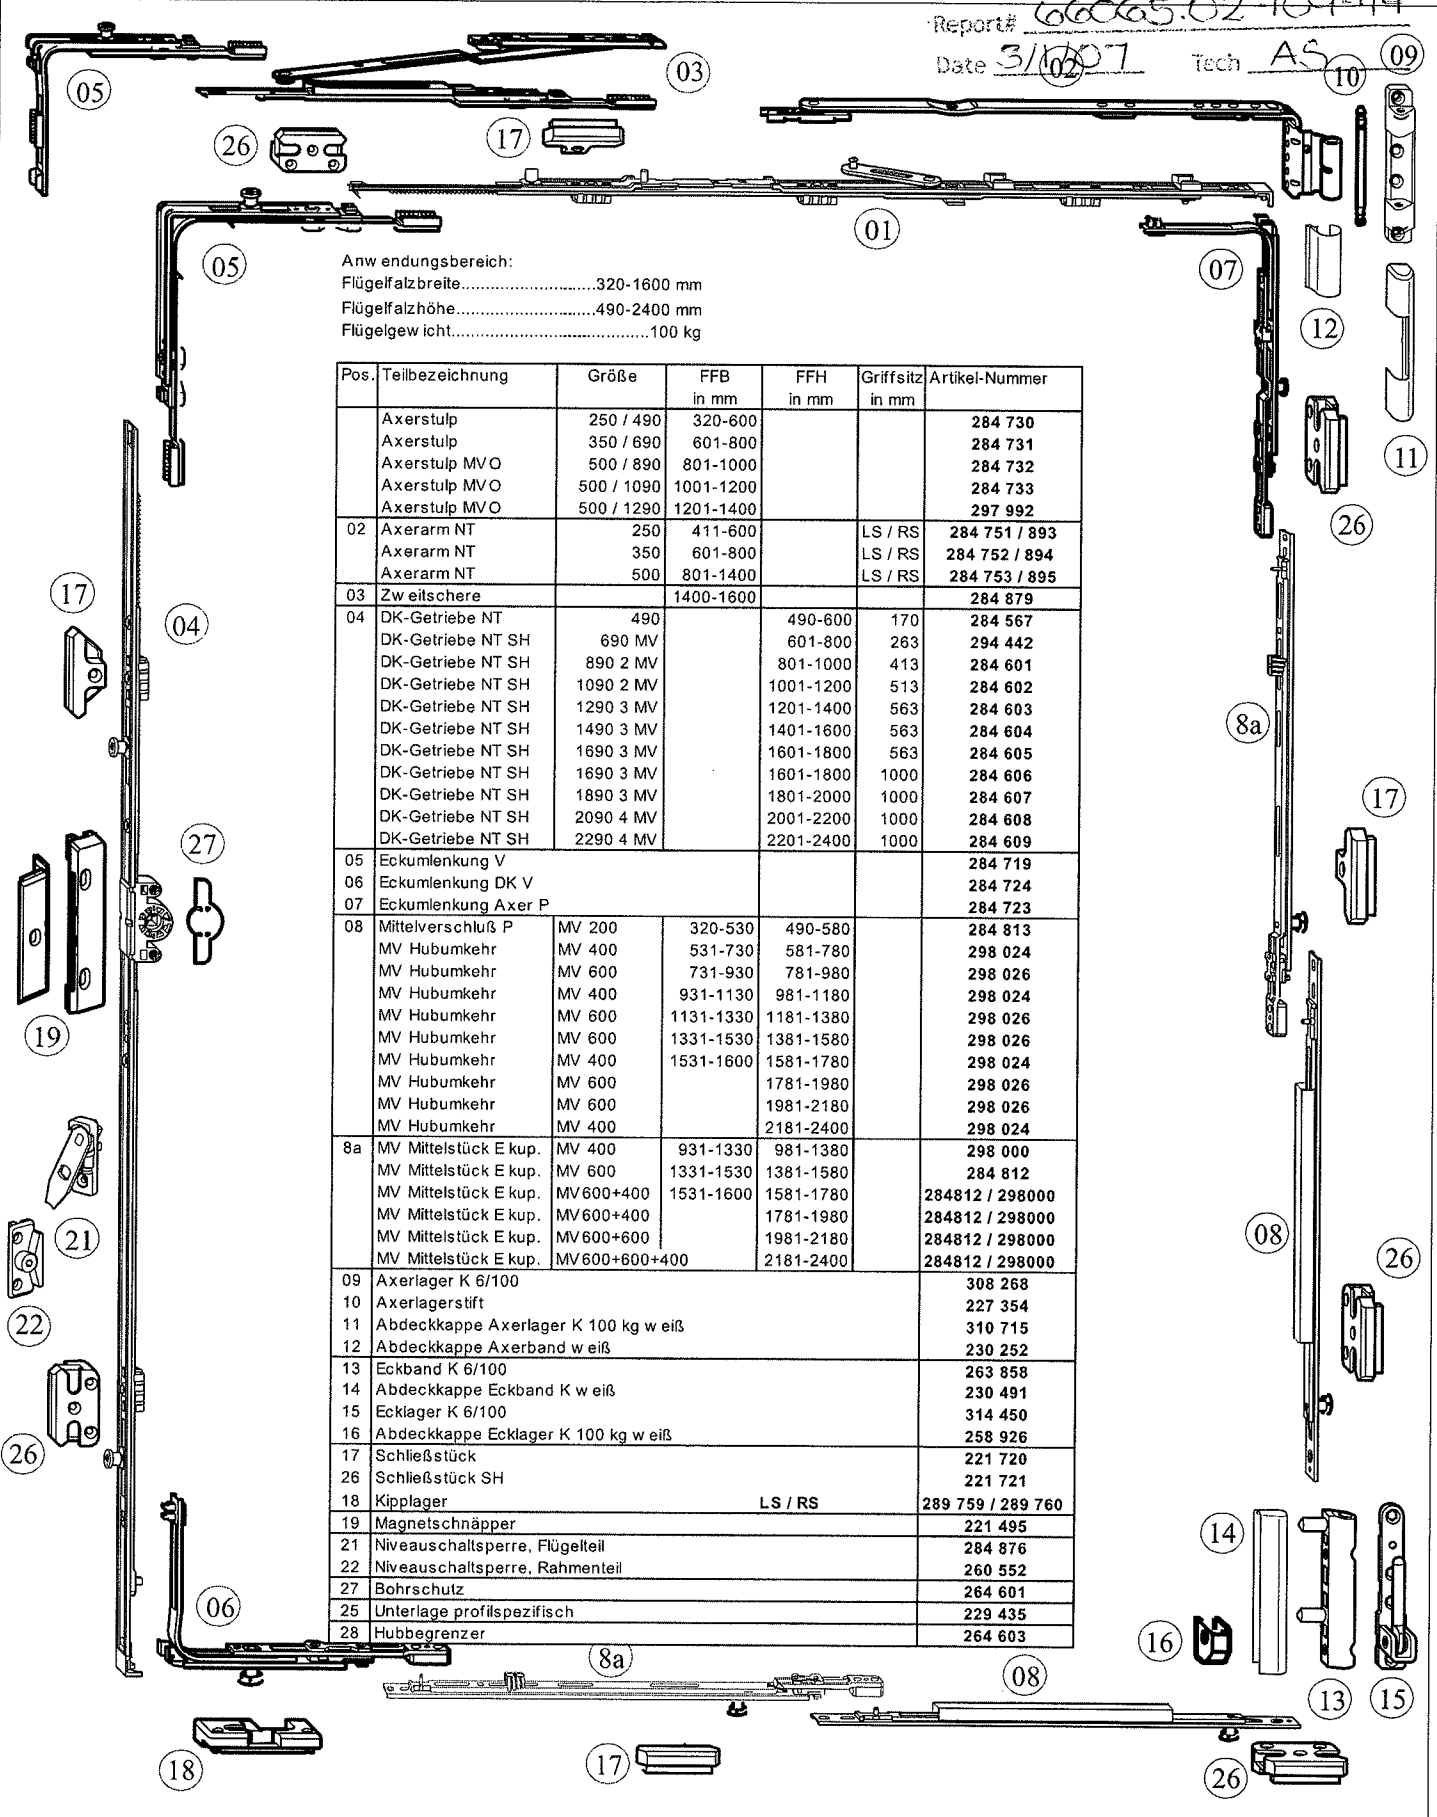

Anwendungsbereich:
 Flügelalzbreite.....320-1600 mm
 Flügelalzhöhe.....490-2400 mm
 Flügelgewicht.....100 kg



Pos.	Teilbezeichnung	Größe	FFB in mm	FFH in mm	Griffsitz in mm	Artikel-Nummer
	Axerstulp	250 / 490	320-600			284 730
	Axerstulp	350 / 690	601-800			284 731
	Axerstulp MVO	500 / 890	801-1000			284 732
	Axerstulp MVO	500 / 1090	1001-1200			284 733
	Axerstulp MVO	500 / 1290	1201-1400			297 992
02	Axerarm NT	250	411-600		LS / RS	284 751 / 893
	Axerarm NT	350	601-800		LS / RS	284 752 / 894
	Axerarm NT	500	801-1400		LS / RS	284 753 / 895
03	Zweitschere		1400-1600			284 879
04	DK-Getriebe NT	490		490-600	170	284 567
	DK-Getriebe NT SH	690 MV		601-800	263	294 442
	DK-Getriebe NT SH	890 2 MV		801-1000	413	284 601
	DK-Getriebe NT SH	1090 2 MV		1001-1200	513	284 602
	DK-Getriebe NT SH	1290 3 MV		1201-1400	563	284 603
	DK-Getriebe NT SH	1490 3 MV		1401-1600	563	284 604
	DK-Getriebe NT SH	1690 3 MV		1601-1800	563	284 605
	DK-Getriebe NT SH	1690 3 MV		1601-1800	1000	284 606
	DK-Getriebe NT SH	1890 3 MV		1801-2000	1000	284 607
	DK-Getriebe NT SH	2090 4 MV		2001-2200	1000	284 608
	DK-Getriebe NT SH	2290 4 MV		2201-2400	1000	284 609
05	Eckmolenkung V					284 719
06	Eckmolenkung DK V					284 724
07	Eckmolenkung Axer P					284 723
08	Mittelverschluß P	MV 200	320-530	490-580		284 813
	MV Hubumkehr	MV 400	531-730	581-780		298 024
	MV Hubumkehr	MV 600	731-930	781-980		298 026
	MV Hubumkehr	MV 400	931-1130	981-1180		298 024
	MV Hubumkehr	MV 600	1131-1330	1181-1380		298 026
	MV Hubumkehr	MV 600	1331-1530	1381-1580		298 026
	MV Hubumkehr	MV 400	1531-1600	1581-1780		298 024
	MV Hubumkehr	MV 600		1781-1980		298 026
	MV Hubumkehr	MV 600		1981-2180		298 026
	MV Hubumkehr	MV 400		2181-2400		298 024
8a	MV Mittelstück E kup.	MV 400	931-1330	981-1380		298 000
	MV Mittelstück E kup.	MV 600	1331-1530	1381-1580		284 812
	MV Mittelstück E kup.	MV 600+400	1531-1600	1581-1780		284812 / 298000
	MV Mittelstück E kup.	MV 600+400		1781-1980		284812 / 298000
	MV Mittelstück E kup.	MV 600+600		1981-2180		284812 / 298000
	MV Mittelstück E kup.	MV 600+600+400		2181-2400		284812 / 298000
09	Axerlager K 6/100					308 268
10	Axerlagerstift					227 354
11	Abdeckkappe Axerlager K 100 kg w eiß					310 715
12	Abdeckkappe Axerband w eiß					230 252
13	Eckband K 6/100					263 858
14	Abdeckkappe Eckband K w eiß					230 491
15	Ecklager K 6/100					314 450
16	Abdeckkappe Ecklager K 100 kg w eiß					258 926
17	Schließstück					221 720
26	Schließstück SH					221 721
18	Kipplager			LS / RS		289 759 / 289 760
19	Magnetschnäpper					221 495
21	Niveauschaltsperr, Flügelteil					284 876
22	Niveauschaltsperr, Rahmenteil					260 552
27	Bohrschutz					264 601
25	Unterlage profilspezifisch					229 435
28	Hubbegrenzer					264 603

TOPLINE AD

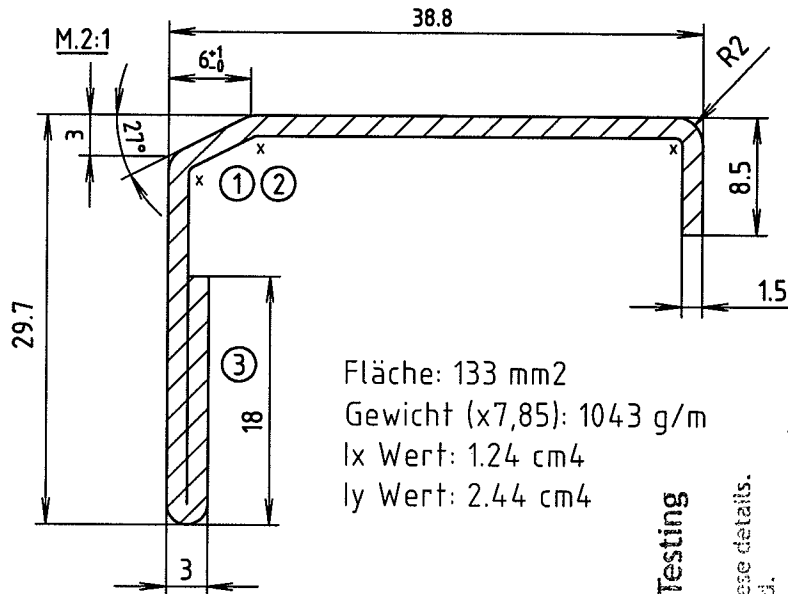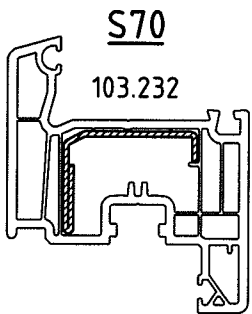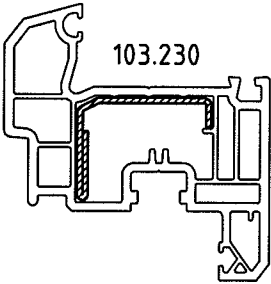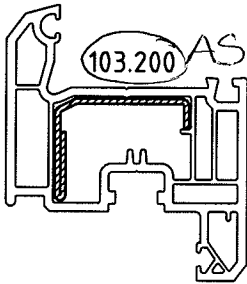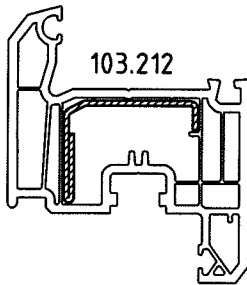


Fläche: 133 mm²
 Gewicht (x7,85): 1043 g/m
 Ix Wert: 1.24 cm⁴
 Iy Wert: 2.44 cm⁴

AD 70

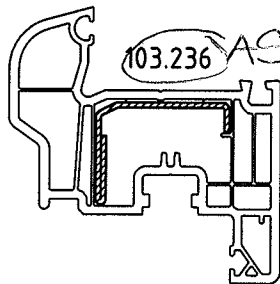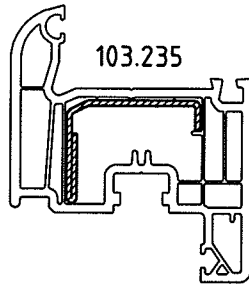

M.1:2

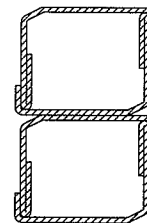


Architectural Testing

Test sample complies with these details.
 Deviations are noted.

Report# 660065.02-109-44

Date 3/1/07 Tech AS

Bündelung:
 In Kleinbunden zu je 4 Stangen,
 die zu Kranbunden von max. 1 to.
 gebündelt werden.

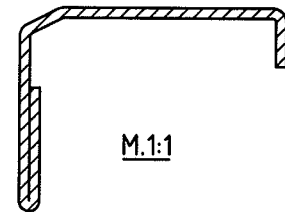

M.1:1

Material: DX51D+275NA

3	Schenkel verkürzt von 20mm auf 18mm. Ix- und Iy-Wert neu gerechnet.	2004-11-23	Wagner
2	Fase 4mm x 45° abgeändert in 6mmx3mm	2002-09-20	Drees
1	Radius 6mm abgeändert in Fase 4mm x 45°	2002-08-19	Schmidt
Index	Aenderung	Datum	Name
Fläche:	133mm ²	Datum:	Name:
Gewicht: (x7,85)	1043g/m	gez.	16.07.2002
Aussenwandung:	1.5mm	ges.	Drees
Freimass:	±0,2	Bemerkung:	
unbem.Radien:w=0,3mm; x=0,5mm; y=0,75mm; z=1,0mm	Diese Zeichnung ist unser geistiges Eigentum. Sie darf ohne unsere Genehmigung weder kopiert noch Dritten zugänglich gemacht werden. VEKA AG; 48324 Sendenhorst		Masstab: M.1:2;1:1;2:1



Profil Systeme

VEKA AG


-Ein Unternehmen der Laumann Gruppe-
 Dieselstrasse 8, 48324 Sendenhorst

Benennung:
Stahlverstärkung für TOP AD / S70 / AD70
 103.200 / .212 / .230 / .232 / .235 / .236
 29.7/38.8/8.5/1.5mm

System: TOP AD / S70 / AD 70 Art.Nr.: 113.292

Zeichnungsnr.: **113.292.1W/3**

DIN-A4

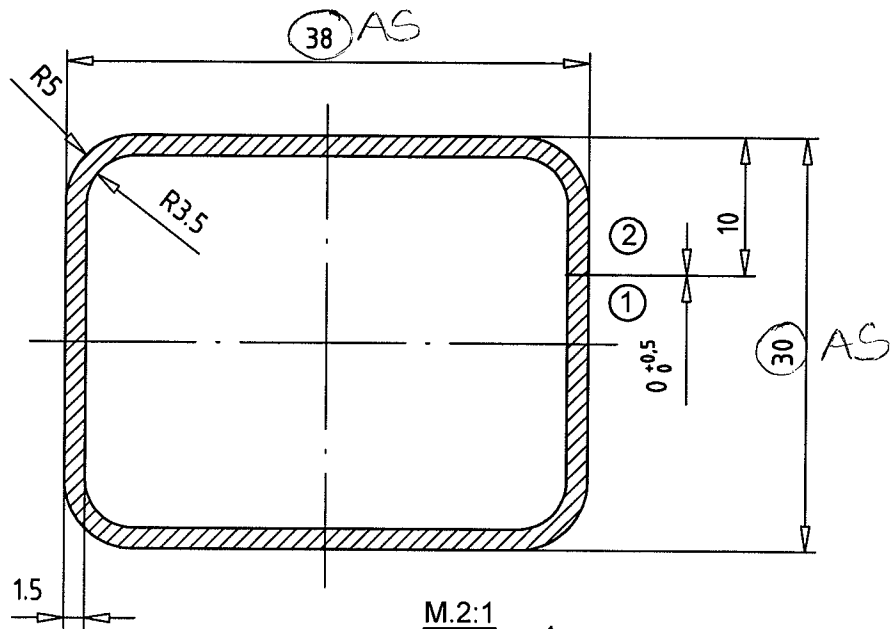

M.2:1

$I_x = 2,55\text{cm}^4$
 $I_y = 3,68\text{cm}^4$




Architectural Testing


Test sample complies with these details.
 Deviations are noted.

Report# 66065.02-109-44

Date 3/1/07 Tech AS

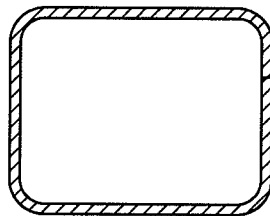


M.1:1


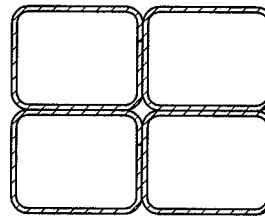


M.1:2


Bündelung:
 In Kleinbunden zu je 4 Stangen,
 die zu Kranbunden von max. 1 to.
 gebündelt werden.

Material: St 02 Z -275 MA


2	Schlitz auf 10mm verlegt	2003-12-16	Drees
1	Trennschlitz von 38er Seite auf 30er Seite verlegt	2003.11.24	Drees
Index	Aenderung	Datum	Name
Flaeche:	183mm ²	Prueflehre	Datum:
Gewicht: (x7,85)	1437g/m	Die Prueflehre ist umlaufend mit +0,3mm zu fertigen!	Name:
Aussenwandung:	1.5mm	Diese Zeichnung ist unser geistiges Eigentum. Sie darf ohne unsere Genehmigung weder kopiert noch Dritten zugaenglich gemacht werden. VEKA AG ; 48324 Sendenhorst	gez. 07.10.97
Freimass:	±0,2		ges.
unbem.Radien:w=0,3mm; x=0,5mm; y=0,75mm; z=1,0mm		Bemerkung:	
 Profil Systeme		Benennung:	
		Stahlverstaerkung für 70mm Systeme 30/38/1.5 mm	
VEKA AG -Ein Unternehmen der Laumann Gruppe- Dieselstrasse 8, 48324 Sendenhorst		System: 70mm Systeme	Art.Nr.: 113.271
		Zeichnungsnr.: 113.271.1W/2	DIN-A4

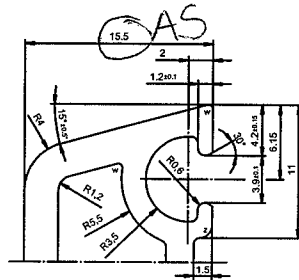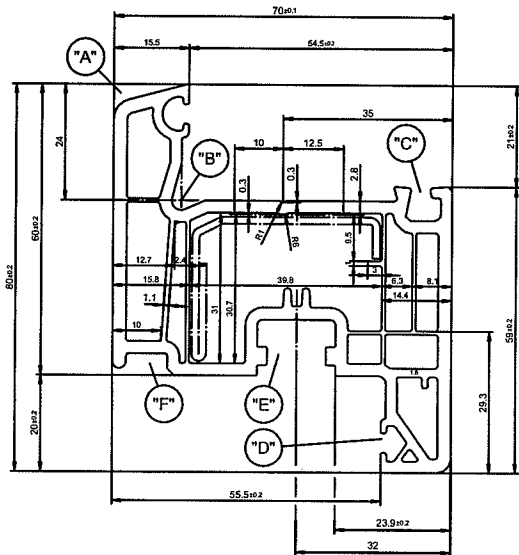

Detail "A"
M 5:1

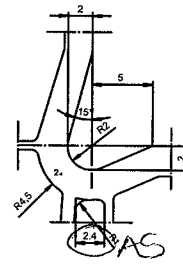

Detail "B"
M 5:1

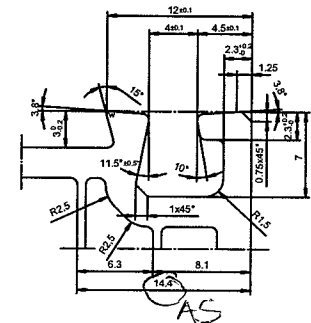

Detail "C"
M 5:1

M 2:1


Verstärkung Art.-Nr. 113.292 (für weiß)
Verstärkung Art.-Nr. 113.294 (für farbig)
Verstärkung Art.-Nr. 113.295 (FST / PSK)

Architectural Testing


Test sample complies with these details.
Deviations are noted.

Report# 60065.02-109-44


Date 3/1/07 Tech AS

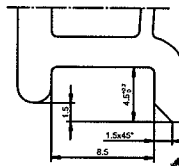


Detail "F"
M 5:1

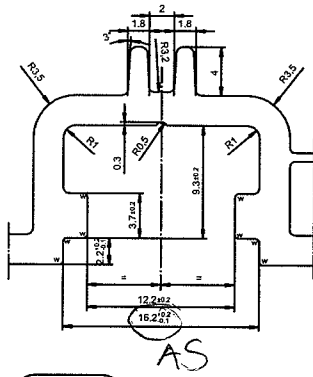

Detail "E"
M 5:1

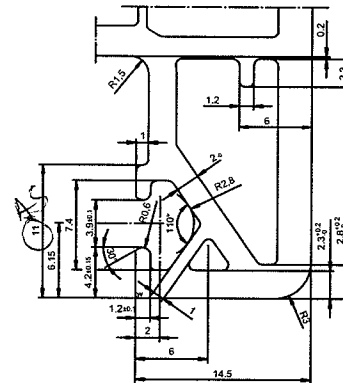

Detail "D"
M 5:1

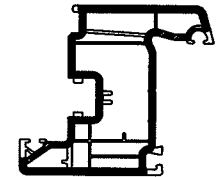


M 1:1

Alle Wandstärken erhalten eine Toleranz von +0.2mm und entsprechen, wenn nicht anders angegeben, den Mindestanforderungen der RAL.

■ 2.8	■ 2.5	■ 2.3	■ 1.2	□ frei
ab 2010	ab 2010	ab 2010	ab 2010	
2.5	2.0			


Alle unbemaßten Innenstöße 0.7mm.
Alle unbemaßten Radien R=0.5mm.

Index	Datum	Name	Änderung	
			Material	PUK
			Fläche	1002mm ²
			Gewicht (x1.41)	1413g/m
			Aussetzänderungen	2.8 → 2.5
			Innenstöße	+0.2mm
			Ergebnis	2.0mm
			Radius	w=0.5, z=0.5, y=0.7, z=1mm
			Bezeichnung	Flügel, nfb. 80mm x 70mm
			Hersteller	VEKA Inc
			Zeichnungsnummer	103.232.18W
			System	SOFTLINE 70 AD
			Art.-Nr.	103.232
			Name	A. Wagner

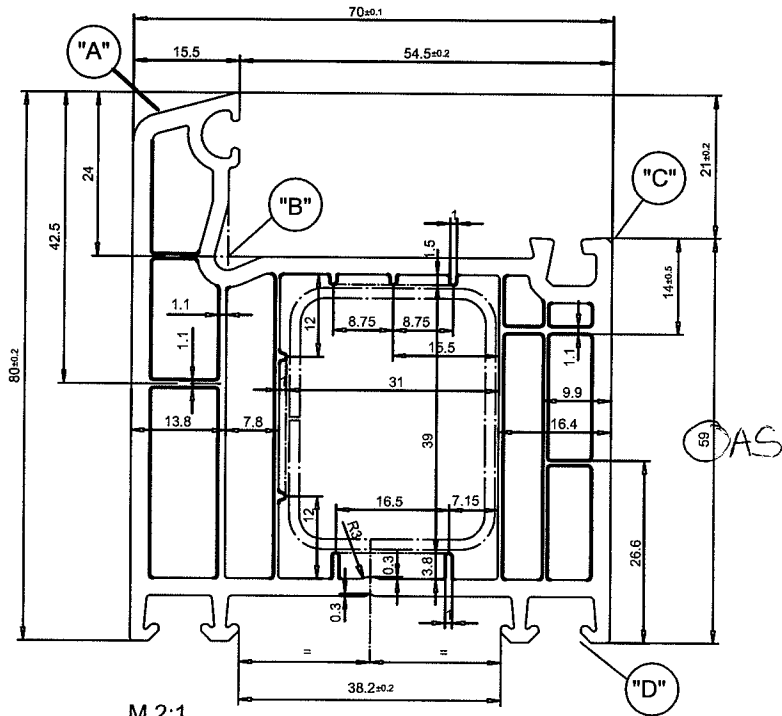


M 2:1

Verstärkung 38x30: Art.-Nr.113.271
Art.-Nr.113.302

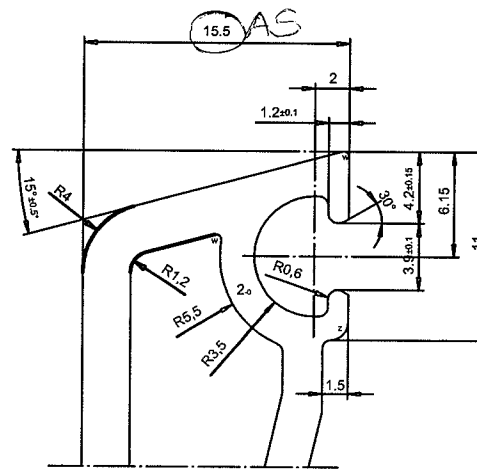

Detail "A"
M 5:1

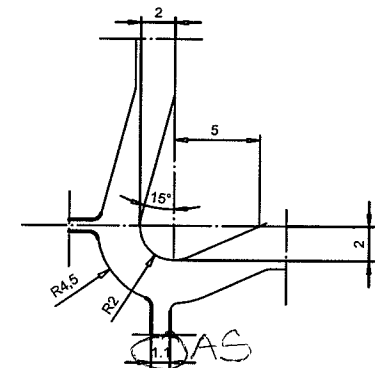

Detail "B"
M 5:1




Architectural Testing

Test sample complies with these details.
Deviations are noted.

Report# 66065.02-109-44

Date 3/1/07 Tech AS

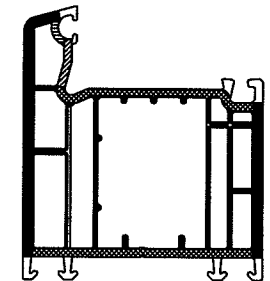


M.1:1


Alle Wandstärken erhalten eine Toleranz von +0.2mm und entsprechen, wenn nicht anders angegeben, den Mindestanforderungen der RAL.

2.8 ± 0	2.5 ± 0	2.3 ± 0	1.2 ± 0	frei
		ab 2010:	ab 2010:	
		2.5 ± 0	2.0 ± 0	

Alle unbemaßten Innenstege 0.7mm.
Alle unbemaßten Radien R=0.5mm.

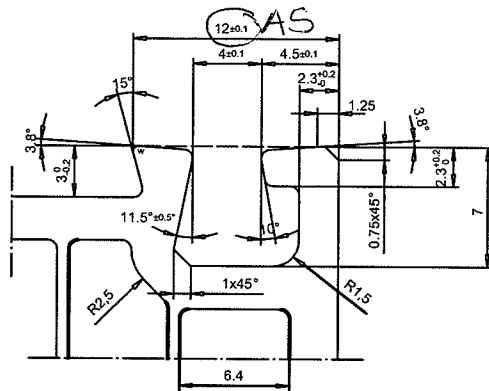


Detail "C"
M 5:1

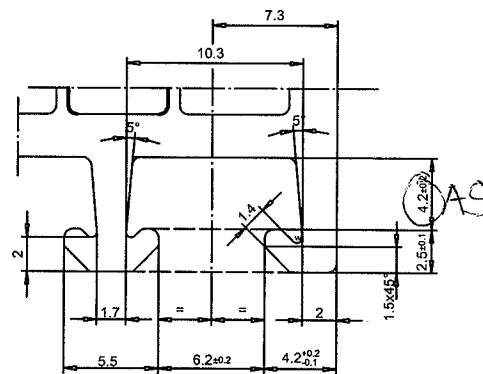

Detail "D"
M 5:1

Index	Datum	Name	Änderung	
			Material:	PVC
			Fläche:	1015mm ²
			Gewicht (x1,41):	1431g/m
			Außenwandungen:	2,8 -0,2mm
			Innenstege:	+0,2mm; 0,7 / 1,1mm
			Freimaß:	± 0,2mm
			Radial:	w=0,3; x=0,5; y=0,7; z=1mm
			Bezeichnung:	Blendrahmen 80mm x 70mm
			VEKA Inc	Maßstab: 1:1; 5:1 2:1
			Ersteller:	Kontrolle:
			Datum:	2006-11-03
			Name:	A. Wagner
			Zeichnungsnummer:	101.214.6W
			System:	SOFTLINE 70 AD
			Art.Nr.:	101.214

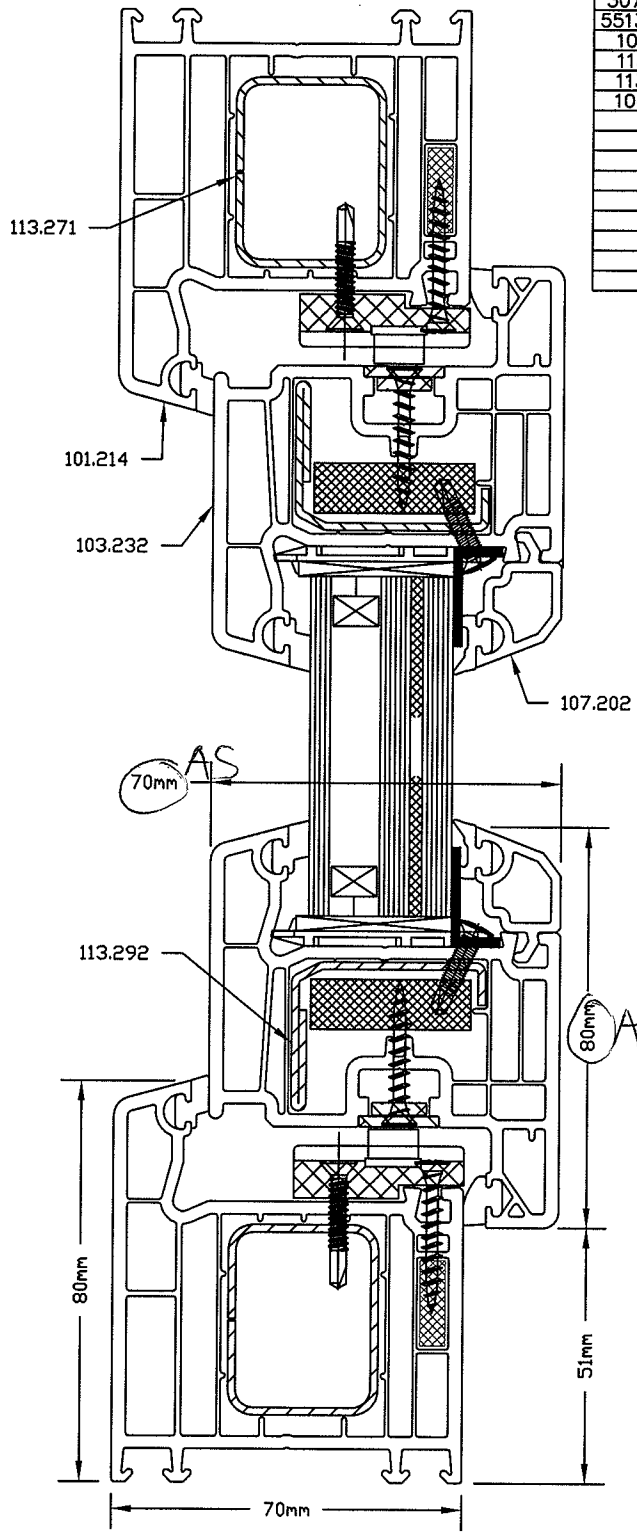

BILL OF MATERIALS		
PART #	DESCRIPTION	SUPPLIER
101.214	FRAME	
103.232	SASH	
107.202	GLAZING BEAD	
304.100.2	PVC INSERT 10x30	
307.060.2	PVC INSERT 6x17	
5513/5515	GLAZING BLOCK	
109.201	GLAZING SPACER	
113.271	FRAME REINFORCEMENT	
113.292	SASH REINFORCEMENT	
104.209	ALUMINUM CLIP	
	SELF TAPPING SCREW 3.9mm X 25mm	WURTH
	SCREW 4.1mm X 30mm	WURTH
	SELF TAPPING SCREW 3.9mm X 32mm	WURTH
	WINDOW HANDLE_099/US_952 (8106577)	HOPPE
	HARDWARE ROTO, CONFIGURATION 500 PLUS	ROTO
	INSULATED GLASS IG	
	GLASS BUILD UP	
	6mm FLOAT FOIL 6mm FLOAT/Lzr 10mm/4mm FLOAT	NOWAK
	FOIL SALFLEX PVB FOIL NACH DIN EN 10204-2.1	SOLUTIA



Architectural Testing
 Test sample complies with these details.
 Deviations are noted.
 Report# 66065.02-109-44
 Date 3/1/07 Tech AS

The information, design or data shown on this document or electronic media is the exclusive property of Veka Inc.. It is considered confidential and proprietary and is made available for limited use only. Its use or reproduction without the expressed written consent of Veka Inc. is prohibited.


NOTE:
 FOR OTHER PROFILE, GLAZING BEAD, & GLASS OPTIONS, PLEASE SEE THE LINEAL PROFILE CHARTS FOR THIS SYSTEM.



VEKA COMMERCIAL
 WINDOW DIVISION
 100 VEKA DRIVE
 FOMBELL, PA 16123

DRAWN: JLB	DATE: 10/26/06	SCALE: FULL
CHK'D:	DATE:	APP'V'D:
TITLE: SOFTLINE 70 TILT TURN VERTICAL ASSEMBLY DETAIL		DWG. # SECTION D-D V
		PAPER SIZE: B

The information, design or data shown on this document or electronic media is the exclusive property of Veka Inc.. It is considered confidential and proprietary and is made available for limited use only. Its use or reproduction without the expressed written consent of Veka Inc. is prohibited.

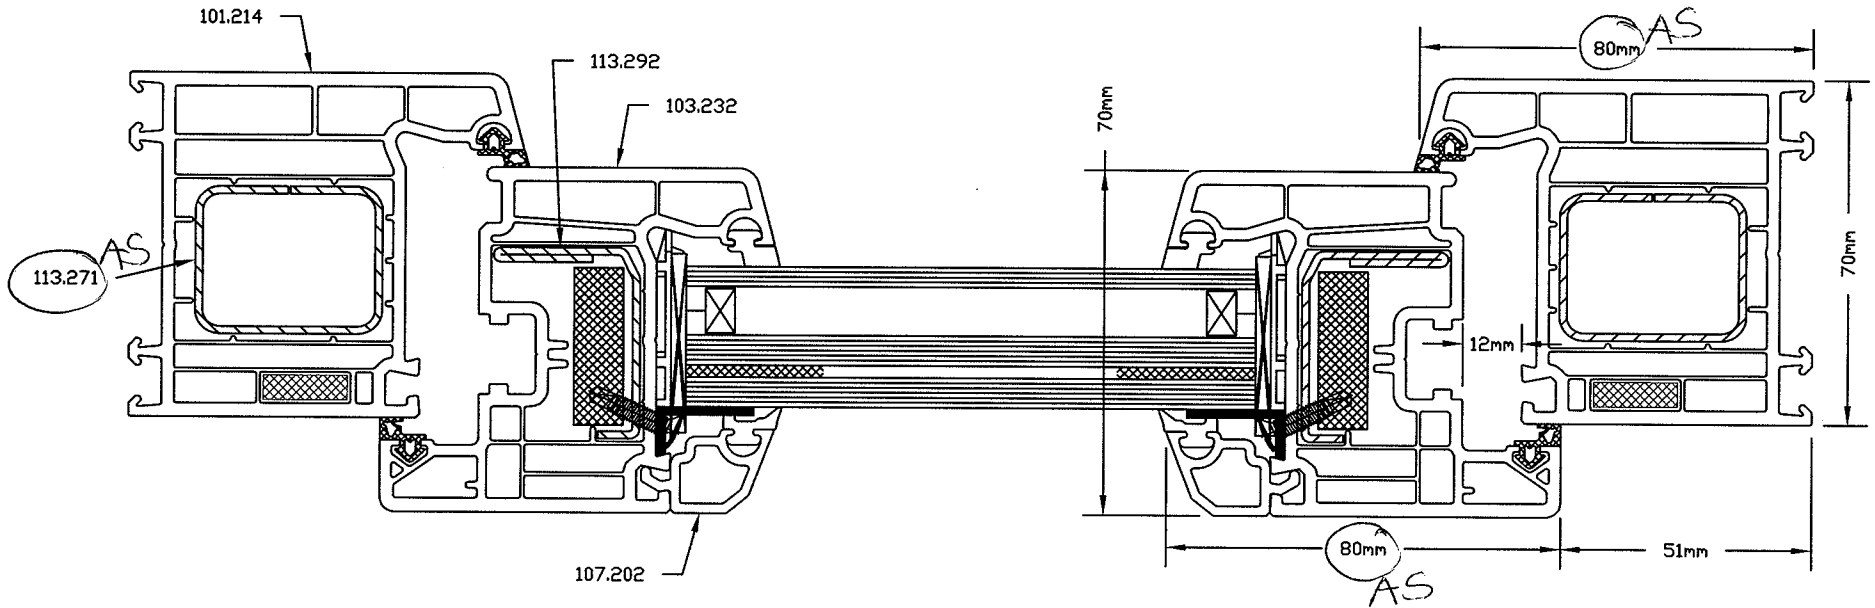

Architectural Testing

Test sample complies with these details.
Deviations are noted.

Report# 66065.02-109-44

Date 3/1/07 Tech AS

NOTE:
FOR OTHER PROFILE, GLAZING BEAD,
& GLASS OPTIONS, PLEASE SEE THE
LINEAL PROFILE CHARTS FOR THIS
SYSTEM.




**VEKA COMMERCIAL
WINDOW DIVISION**


100 VEKA DRIVE
FOMBELL, PA 16123

DRAWN: JLB	DATE: 10/26/06	SCALE: FULL
CHK'D:	DATE:	APP'VD:
TITLE: SOFTLINE 70 TILT TURN HORIZONTAL ASSEMBLY		DWG. # SECTION C-C V

The information, design or data shown on this document or electronic media is the exclusive property of Veka Inc. It is considered confidential and proprietary and is made available for limited use only. Its use or reproduction without the expressed written consent of Veka Inc. is prohibited.

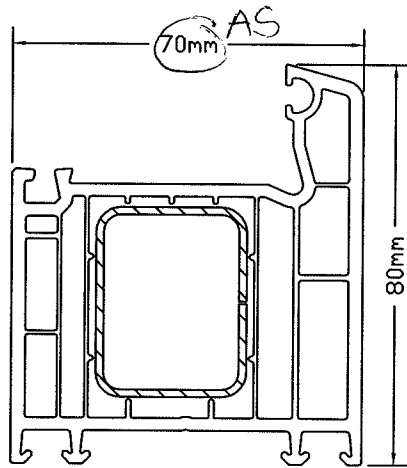

101.214 - FRAME
REINFORCEMENT - 113.271

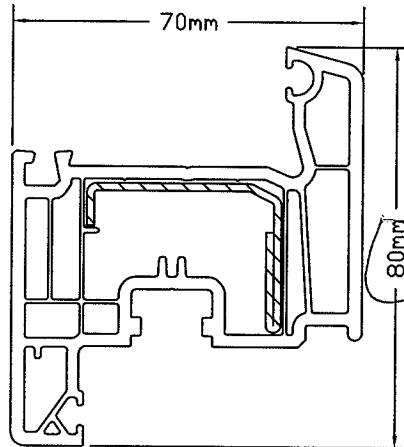

103.232 - SASH
REINFORCEMENT - 113.292




Architectural Testing

Test sample complies with these details.
Deviations are noted.

Report# 66065.02-109-44

Date 3/1/07 Tech AS

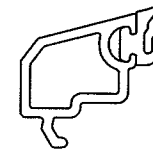

107.202
GLAZING BEAD

NOTE:
FOR OTHER PROFILE, GLAZING BEAD,
& GLASS OPTIONS, PLEASE SEE THE
LINEAL PROFILE CHARTS FOR THIS
SYSTEM.




**VEKA COMMERCIAL
WINDOW DIVISION**


100 VEKA DRIVE
FOMBELL, PA 16123

DRAWN: JLB	DATE: 20 NOV 06	SCALE: FULL
CHK'D:	DATE:	APPVD:
TITLE: SOFTLINE 70 TILT TURN PROFILE CHART		DWG. # PCHARTV

The information, design or data shown on this document or electronic media is the exclusive property of Veka Inc. It is considered confidential and proprietary and is made available for limited use only. Its use or reproduction without the expressed written consent of Veka Inc. is prohibited.

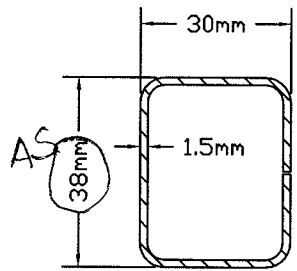

101.214 - FRAME
REINFORCEMENT - 113.271

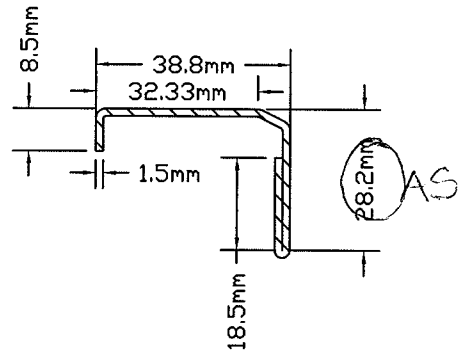

103.232 - SASH
REINFORCEMENT - 113.292



Architectural Testing

Test sample complies with these details.
Deviations are noted.

Report# 66005.02-109-44
Date 3/1/07 Tech AS


NOTE:
FOR OTHER PROFILE, GLAZING BEAD,
& GLASS OPTIONS, PLEASE SEE THE
LINEAL PROFILE CHARTS FOR THIS
SYSTEM.



**VEKA COMMERCIAL
WINDOW DIVISION**
100 VEKA DRIVE
FOMBELL, PA 16123

DRAWN: JLB	DATE: 14 NOV 06	SCALE: FULL
CHK'D:	DATE:	APPV'D:
TITLE: SOFTLINE 70 TILT TURN PROFILE CHART REINFORCEMENT		DWG. # PCHARTSTEELY

REVISIONS			
NO.	DESCRIPTION	DATE	APPR.

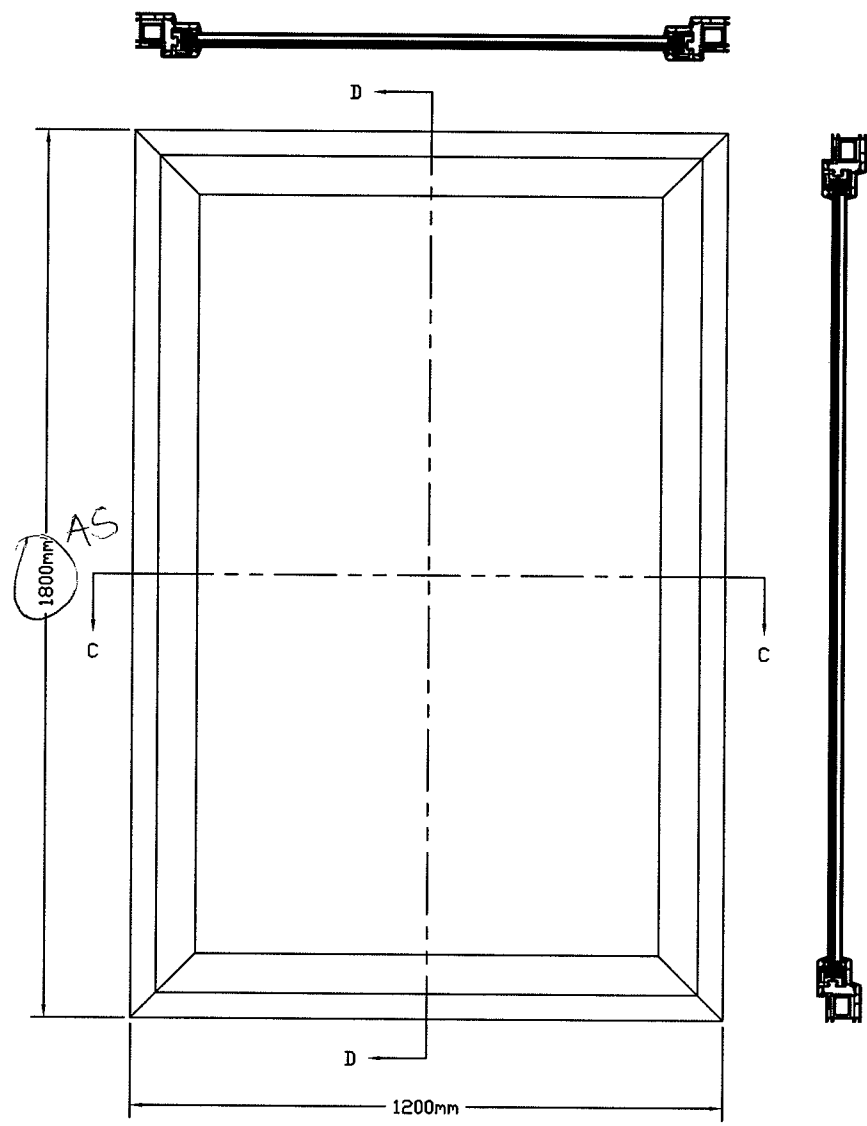

Architectural Testing

Test sample complies with these details.
Deviations are noted.

Report# 66065.01-109-44

Date 3/1/07 Tech AS



VEKA COMMERCIAL WINDOW DIVISION
100 Veka Drive
Pottsville, PA 16123

DRAWN: JLS	DATE: 20 OCT 06	SCALE: 1:4
CHECK: JLS	DATE:	APPR:
TITLE: 2000 X 1800 SWIRL OPERING	PAPER SIZE: D	DWG. NUMBER: SECTION V


The information, design or data shown on this document or electronic media is the exclusive property of Veka Inc.. It is considered confidential and proprietary and is made available for limited use only. Its use or reproduction without the expressed written consent of Veka Inc. is prohibited.



Architectural Testing

Test sample complies with these details.
Deviations are noted.

Report# 66065.02-109-44
Date 3/1/07 Tech AS

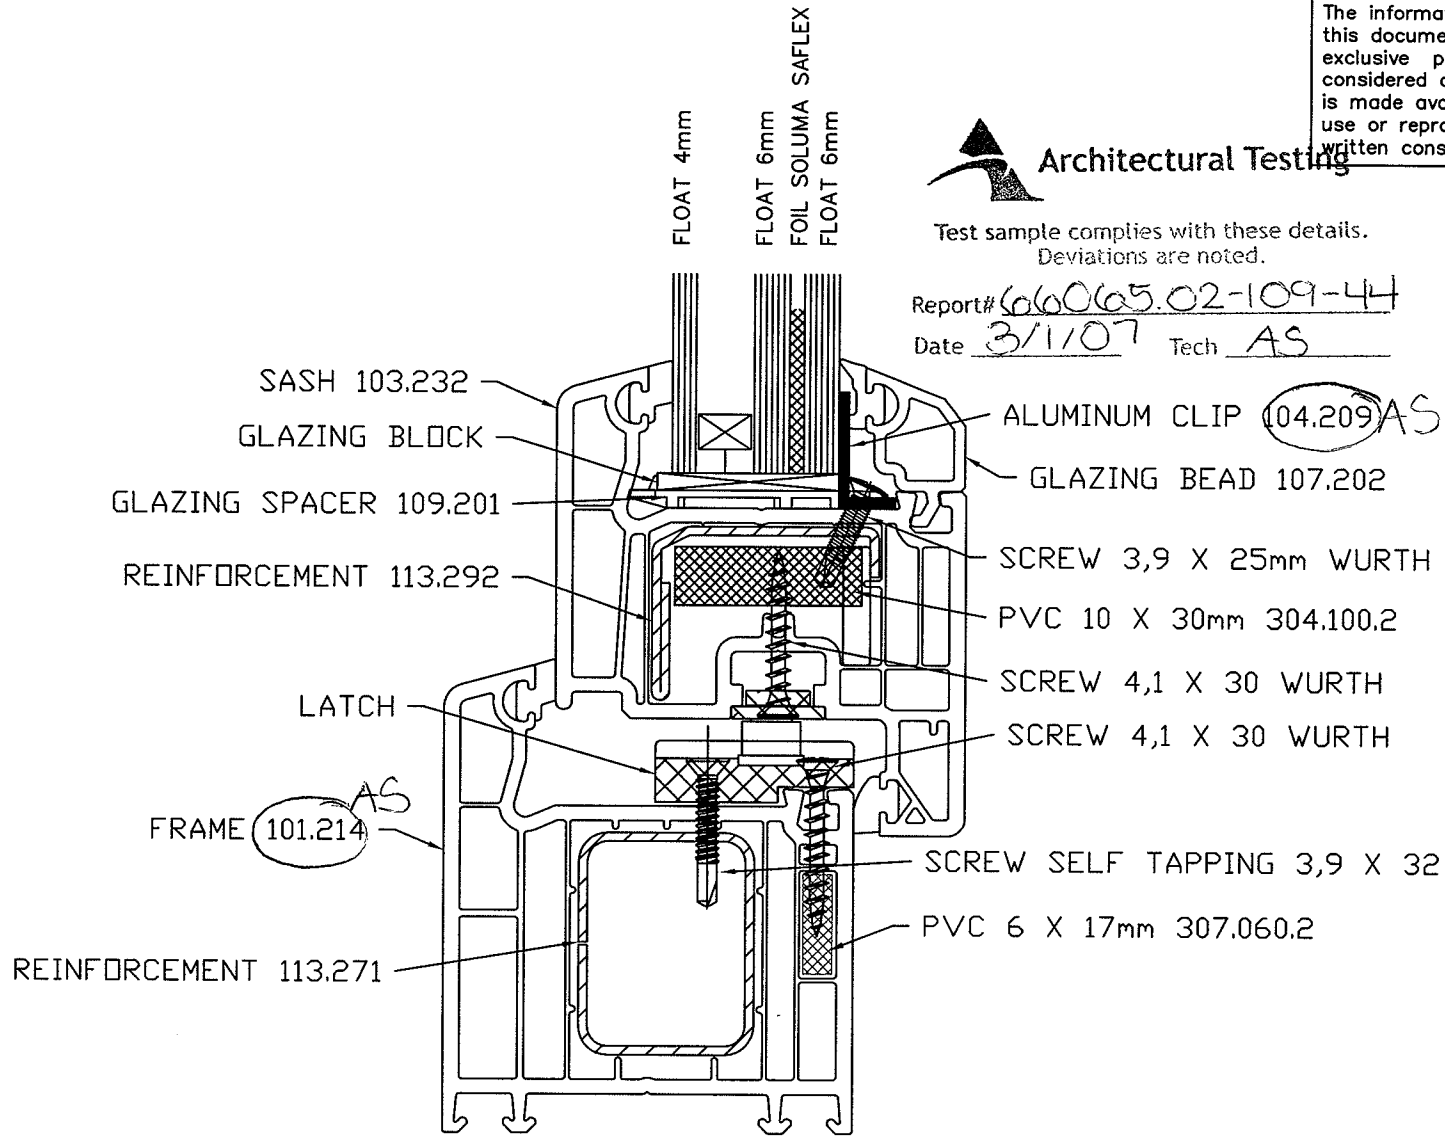

NOTE:
FOR OTHER PROFILE, GLAZING BEAD,
& GLASS OPTIONS, PLEASE SEE THE
LINEAL PROFILE CHARTS FOR THIS
SYSTEM.



VEKA COMMERCIAL
WINDOW DIVISION

100 VEKA DRIVE
FOMBELL, PA 16123

DRAWN: JLB	DATE: 10/31/06	SCALE: 3/4	
CHK'D:	DATE:	APP'VD:	PAPER SIZE: A
TITLE: SOFTLINE 70 TILT TURN UNIT & FIXED POST			DWG. # LOCATION V

REVISIONS			
REV	DESCRIPTION	DATE	APPVD

GLASS CLIPS 20/10/2, LENGTH 100mm



Architectural Testing

Test sample complies with these details.
Deviations are noted.

Report# 66065.02-109-44

Date 3/1/07 Tech AS



VEKA COMMERCIAL WINDOW DIVISION
100 Veka Drive
Fombell, PA 16123

DRAWN: JLB	DATE: 28 OCT 06	SCALE: 1:3
CHECKED:	DATE:	APPVD:
TITLE: SOFTLINE TO TILT TURN GLASS CLIPS	PAPER SIZE: D	DWG.: GLASS CLIPS V