

TEST REPORT

Report No. A7802.01-501-47

Rendered to:

VEKA INC.
Fombell, Pennsylvania

PRODUCT TYPE: PVC Horizontally Sliding Window, Type XO
SERIES/MODEL: SS93WW

SPECIFICATION: AAMA/WDMA/CSA 101/I.S.2/A440-08, *NAFS - North American Fenestration Standard/Specification for Windows, Doors, and Skylights*

Title	Summary of Results	
	Test Specimen #1 Vertical Reinforcement	Test Specimen #2 Full Reinforcement
Primary Product Designator	Class R-PG45 1930 x 1371 (76 x 54) - HS	Class R-PG45 1930 x 1371 (76 x 54) - HS
Design Pressure	+2160 Pa (+45.11 psf)	+2160 Pa (+45.11 psf)
Negative Design Pressure	-2400 Pa (-50.13 psf)	-3120 Pa (-65.16.13 psf)
Air Infiltration	0.5 L/s/m ² (0.09 cfm/ft ²)	N/A
Water Penetration Resistance Test Pressure	330 Pa (6.90 psf)	N/A

Test Completion Date: 02/16/2011

Reference must be made to Report No. A7797.01-501-47, dated 02/22/11 for complete test specimen description and detailed test results.

1.0 Report Issued To: Veka Inc.
100 Veka Drive
Fombell, Pennsylvania 16123-025

2.0 Test Laboratory: Architectural Testing, Inc.
1140 Lincoln Avenue
Springdale, Pennsylvania 15144
724-275-7100

3.0 Project Summary:

3.1 Product Type: PVC Horizontal Sliding Window, Type XO

3.2 Series/Model: SS93WW

Compliance Statement: Results obtained are tested values and were secured by using the designated test method(s). The specimens tested successfully met the performance requirements for the following ratings: Test Specimen #1: **Class R-PG45 1930 x 1371 (76 x 54) - HS**; Test Specimen #2: **Class R-PG45 1930 x 1371 (76 x 54) - HS**.

3.3 Test Dates: 02/15/2011 – 02/16/2011

3.4 Test Location: Veka Inc. test facility in Fombell, Pennsylvania. Calibration of test equipment was performed by Architectural Testing in accordance with AAMA 205-01 "In-Plant Testing Guidelines for Manufacturers and Independent Laboratories".

3.5 Test Sample Source: The test specimens were provided by the client. Representative samples of the test specimen(s) will be retained by Architectural Testing for a minimum of four years from the test completion date.

3.6 Drawing Reference: The test specimen drawings have been reviewed by Architectural Testing and are representative of the test specimen(s) reported herein. Test specimen construction was verified by Architectural Testing per the drawings located in Appendix B. Any deviations are documented herein or on the drawings.

3.7 List of Official Observers:

<u>Name</u>	<u>Company</u>
Doug Merry	Veka Inc.
Cornell Charles	Veka Inc.
Joseph Allison	Architectural Testing, Inc.

4.0 Test Specification(s):

AAMA/WDMA/CSA 101/I.S.2/A440-08, *NAFS - North American Fenestration Standard/Specification for Windows, Doors, and Skylights*

5.0 Test Specimen Description:

5.1 Product Sizes:

Test Specimen #1:

Overall Area: 2.6 m ² (28.5 ft ²)	Width		Height	
	millimeters	inches	millimeters	inches
Overall size	1930	76	1371	54
Sash size	975	38-3/8	1295	51
Screen size	930	36-5/8	1311	51-5/8

Test Specimen #2:

Overall Area: 2.6 m ² (28.5 ft ²)	Width		Height	
	millimeters	inches	millimeters	inches
Overall size	1930	76	1371	54
Sash size	975	38-3/8	1295	51
Screen size	930	36-5/8	1311	51-5/8

The following descriptions apply to all specimens.

5.2 Frame Construction:

Frame Member	Material	Description
Head, sill, jambs, fixed stile	PVC	Extruded

	Joinery Type	Detail
All corners	Mitered	Thermally welded
Fixed rail	Square cut and coped	Fastened with four #8 x 2" truss head screws, two at each end

5.0 Test Specimen Description: (Continued)

5.3 Sash Construction:

Sash Member	Material	Description
All rails and stiles	PVC	Extruded

	Joinery Type	Detail
All corners	Mitered	Thermally welded

5.4 Weatherstripping:

Description	Quantity	Location
0.187" x 0.270" center fin pile	3 Rows	Bottom rail, jamb stile
0.187" x 0.270" center fin pile	2 Rows	Fixed meeting stile
0.187" x 0.270" center fin pile	1 Row	Frame perimeter, lock stile, top rail

5.5 Glazing:

Glass Type	Spacer Type	Interior Lite	Exterior Lite	Glazing Method
1" IG	Rectangular shaped steel, single sealed	1/8" annealed	1/8" annealed	The sash and fixed lite were exterior glazed. The glass was set against a double-sided adhesive tape and secured with rigid vinyl glazing beads.

Location	Quantity	Daylight Opening		Glass Bite
		millimeters	inches	
Sash	1	876 x 1197	34-1/2 x 47-1/8	5/8"
Fixed lite	1	876 x 1273	34-1/2 x 50-1/8	5/8"

5.0 Test Specimen Description: (Continued)

5.6 Drainage:

Drainage Method	Size	Quantity	Location
Weepslot with cover	1-5/16" by 5/16"	2	Exterior sill face, one 3-1/2" in from each end.
Weepslot with open cell foam baffle	1" by 1/4"	2	Interior sill track, one at each end.
Weepslot	1" by 1/4"	2	Sill intermediate wall, one at each end

5.7 Hardware:

Description	Quantity	Location
Metal cam lock and keeper	2	Lock stile, one 8" in from each end with corresponding metal keeper on the fixed meeting stile.
Dual metal rollers with plastic housing	2	Bottom rail, one at each end

5.8 Reinforcement:

Drawing Number	Location	Material
RF SE9346 AOM	Lock stile (Specimen #1 and #2)	Extruded aluminum
RF SH9304 AOM	Fixed meeting stile (Specimen #1 and #2)	Extruded aluminum
RF SE9345 AOM	Jamb stile (Specimen #1 and #2)	Extruded aluminum
RF SE9345 AOM	Top rail, bottom rail (Specimen #2 only)	Extruded aluminum

5.9 Screen Construction:

Frame Material	Corner Construction	Mesh Type	Mesh Attachment Method
Roll-formed aluminum	Square-cut and secured with snap-in plastic corner keys	Fiber	Flexible vinyl spline

6.0 Installation:

The specimen was installed into a Spruce-Pine-Fir wood buck. The rough opening allowed for a 1/8" shim space. The exterior perimeter of the window was sealed with sealant. The sill was set onto a bed of silicone sealant.

Test Specimen #1:

Location	Anchor Description	Anchor Location
Head, sill	#8 x 2" truss head screws	5 each, evenly spaced and beginning 5" in from each end.
Jambs	#8 x 2" truss head screws	3 per jamb, located 5" in from each end and at midspan.

Test Specimen #2:

Location	Anchor Description	Anchor Location
Head, sill	#8 x 2" truss head screws	5 per head / sill, located 5" from each end and then evenly spaced. Two additional screws per head / sill located 6" from each side of midspan. (7 total)
Jambs	#8 x 2" truss head screws	3 per jamb, located 5" in from each end and at midspan.

7.0 Test Results: The temperature during testing was 20°C (68°F). The results are tabulated as follows:

Test Specimen #1:

Title of Test	Results	Allowed	Note
Operating Force, per ASTM E 2068	Initiate motion: 89 N (20 lbf) Maintain motion: 58 N (13 lbf) Latches: N/A Locks: 22 N (5 lbf)	Report Only 90 N (20 lbf) max. 100 N (22.5 lbf) max. 100 N (22.5 lbf) max.	
Air Leakage, Infiltration per ASTM E 283 at 75 Pa (1.6 psf)	0.5 L/s/m ² (0.09 cfm/ft ²)	1.5 L/s/m ² (0.3 cfm/ft ²) max.	1
Water Penetration, per ASTM E 547	N/A	N/A	3
Uniform Load Deflection, per ASTM E 330	N/A	N/A	3
Uniform Load Structural, per ASTM E 330	N/A	N/A	3
Forced Entry Resistance, per ASTM F 588, Type: A - Grade: 10	Pass	No entry	
Thermoplastic Corner Weld	Pass	Meets as stated	
Deglazing, per ASTM E 987 Operating direction, 320 N (72 lbf)	Pass	Meets as stated	
Remaining direction, 230 N (52 lbf)	Pass	Meets as stated	

7.0 Test Results: (Continued)

Test Specimen #1: (Continued)

Title of Test	Results	Allowed	Note
Optional Performance			
Water Penetration, per ASTM E 547 at 330 Pa (6.90 psf)	Pass	No leakage	2
Uniform Load Deflection, per ASTM E 330 taken at the fixed meeting stile +2400 Pa (+50.13 psf) -2400 Pa (-50.13 psf)	6.8 mm (0.27") 6.3 mm (0.25")	Report Only	4, 5, 6
Uniform Load Structural, per ASTM E 330 taken at the fixed meeting stile +3600 Pa (+75.19 psf) -3600 Pa (-75.19 psf)	0.3 mm (0.01") 0.3 mm (0.01")	4.6 mm (0.18") max. 4.6 mm (0.18") max.	5, 6

Test Specimen #2:

Title of Test	Results	Allowed	Note
Optional Performance			
Uniform Load Deflection, per ASTM E 330 taken at the fixed meeting stile +3120 Pa (+65.16 psf) -3120 Pa (-65.16psf)	9.05 mm (0.36") 8.5 mm (0.34")	Report Only	4, 5, 6
Uniform Load Structural, per ASTM E 330 taken at the fixed meeting stile +4680 Pa (+97.74 psf) -4680 Pa (-97.74 psf)	0.5 mm (0.02") 0.5 mm (0.02")	5.3 mm (0.21") max. 5.3 mm (0.21") max.	5, 6

7.0 Test Results: (Continued)

Note 1: The tested specimen meets (or exceeds) the performance levels specified in AAMA/WDMA/CSA 101/I.S.2/A440 for air leakage resistance.

Note 2: With and without insect screen.

Note 3: The client opted to start at a pressure higher than the minimum required. Test results are reported under Optional Performance.

Note 4: The deflections reported are not limited by AAMA/WDMA/CSA 101/I.S.2/A440 for this product designation. The deflection data is recorded in this report for special code compliance and information only.

Note 5: Loads were held for 10 seconds.

Note 6: Tape and film were used to seal against air leakage during structural testing. In our opinion, the tape and film did not influence the results of the test.

The service life of this report will expire on the stated Test Record Retention End Date, at which time such materials as drawings, data sheets, samples of test specimens, copies of this report, and any other pertinent project documentation, shall be discarded without notice.

If test specimen contains glazing, no conclusions of any kind regarding the adequacy or inadequacy of the glass in any glazed test specimen(s) can be made. This report does not constitute certification of this product nor an opinion or endorsement by this laboratory. It is the exclusive property of the client so named herein and relates only to the specimen(s) tested. This report may not be reproduced, except in full, without the written approval of Architectural Testing, Inc.

For ARCHITECTURAL TESTING, Inc.

Joseph E. Allison
Senior Technician

Lynn George
Director – Regional Operations

JEA:sld

Attachments (pages): This report is complete only when all attachments listed are included.

Appendix-A: Alteration Addendum (1)

Appendix-B: Drawings (11)



Test Report No.: A7802.01-501-47
Report Date: 02/22/11
Test Record Retention End Date: 02/16/15

Appendix A
Alteration Addendum

Note: No alterations were required.



Test Report No.: A7802.01-501-47
Report Date: 02/22/11
Test Record Retention End Date: 02/16/15

Appendix B


Drawings

Test sample complies with these details.
Deviations are noted.

with vertical reinforcement only


Report# A7802

Date 2/17/11 Tech JMN

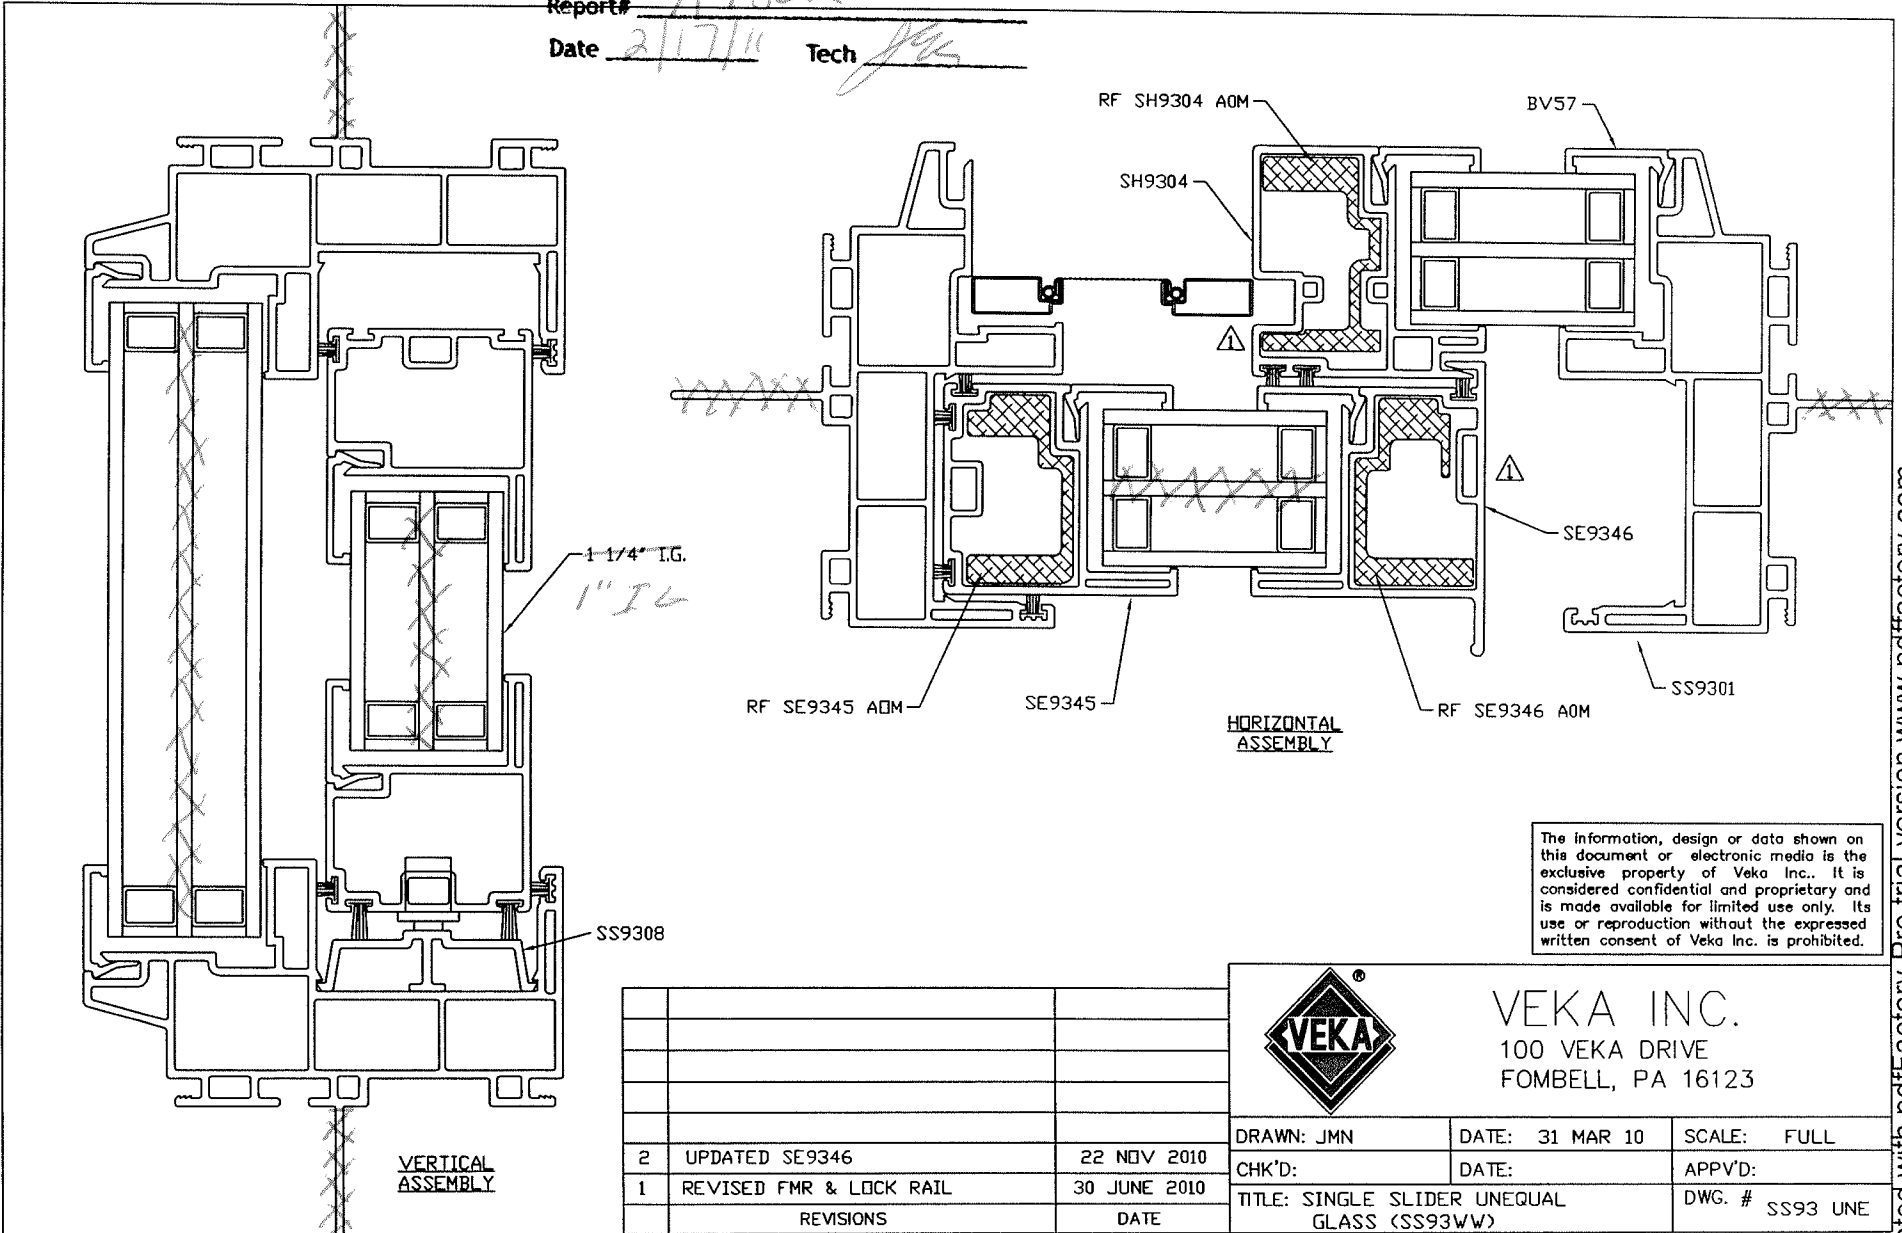

The information, design or data shown on this document or electronic media is the exclusive property of Veka Inc.. It is considered confidential and proprietary and is made available for limited use only. Its use or reproduction without the expressed written consent of Veka Inc. is prohibited.

REVISIONS	DATE
2	UPDATED SE9346
1	REVISED FMR & LOCK RAIL



VEKA INC.
100 VEKA DRIVE
FOMBELL, PA 16123

DRAWN: JMN	DATE: 31 MAR 10	SCALE: FULL
CHK'D:	DATE:	APPV'D:
TITLE: SINGLE SLIDER UNEQUAL GLASS (SS93WW)		DWG. # SS93 UNE




Architectural Testing

Test sample complies with these details.
Deviations are noted.

With Full Reinforcement

Report# A7802
Date 2/17/11 Tech JGA

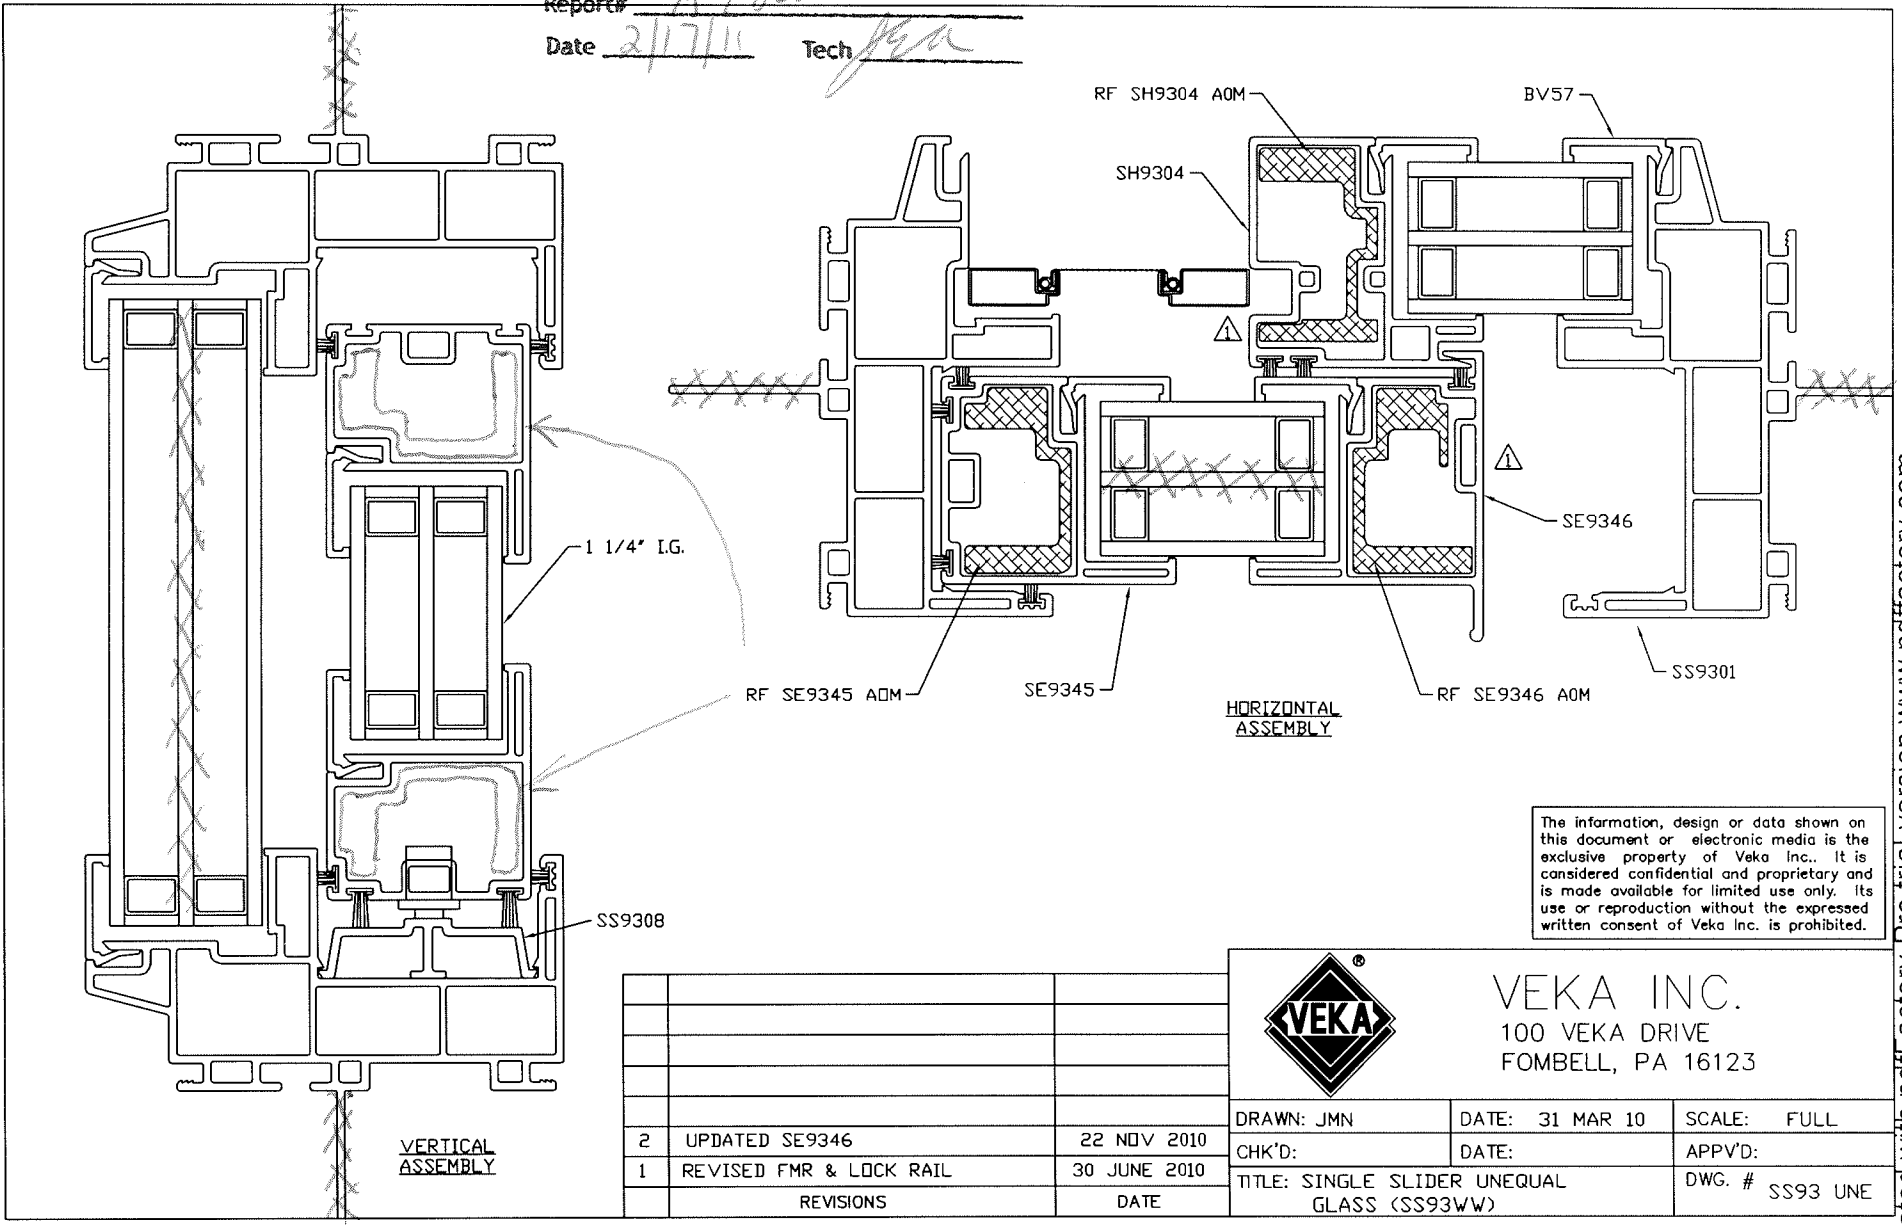

The information, design or data shown on this document or electronic media is the exclusive property of Veka Inc.. It is considered confidential and proprietary and is made available for limited use only. Its use or reproduction without the expressed written consent of Veka Inc. is prohibited.

REVISIONS	DATE
2	22 NOV 2010
1	30 JUNE 2010




VEKA INC.
100 VEKA DRIVE
FOMBELL, PA 16123

DRAWN: JMN	DATE: 31 MAR 10	SCALE: FULL
CHK'D:	DATE:	APP'D:
TITLE: SINGLE SLIDER UNEQUAL GLASS (SS93WW)		DWG. # SS93 UNE

Test sample complies with these details.
Deviations are noted.

Report# A7800
Date 2/17/11 Tech Jan

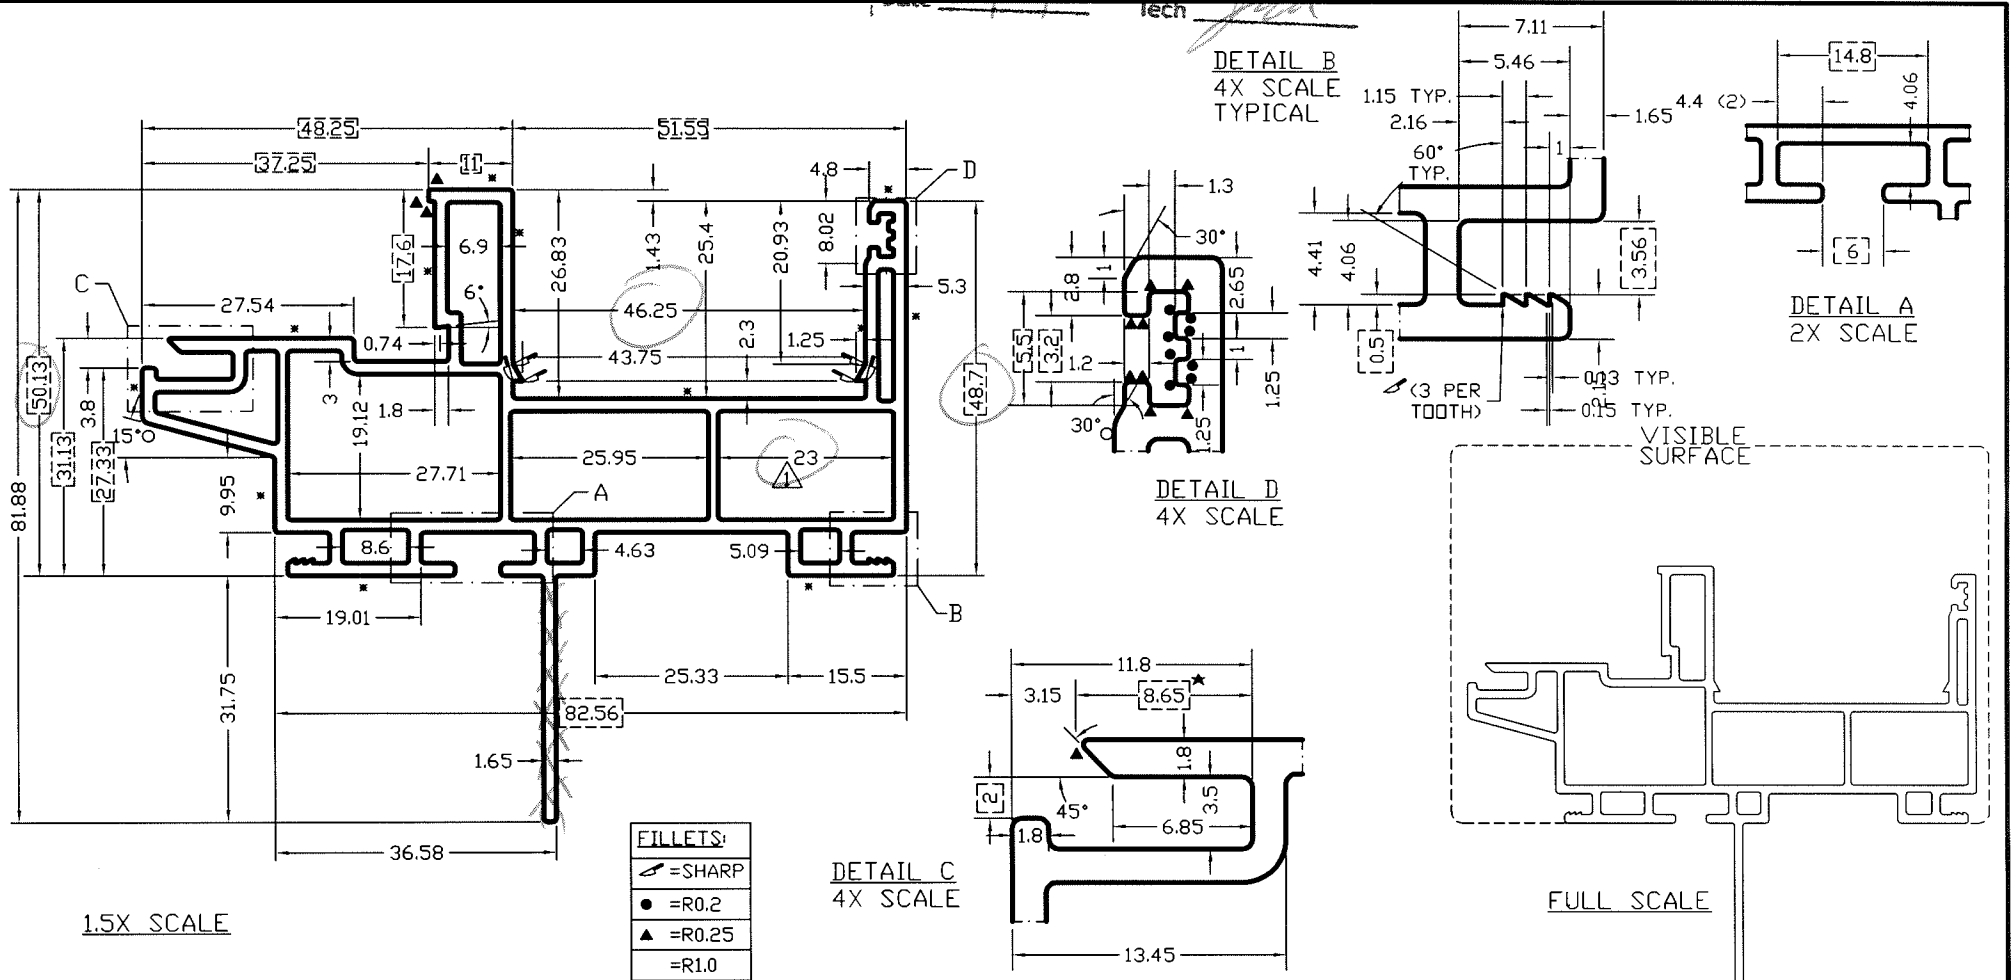

FILLETS:

- = SHARP
- = R0.2
- = R0.25
- = R1.0

DETAIL C
4X SCALE

DETAIL D
4X SCALE

DETAIL B
4X SCALE
TYPICAL

DETAIL A
2X SCALE

FULL SCALE

★ = DIMENSION TAKEN FROM FURTHEST POINT ON RADIUS

MATERIAL: RIGID PVC


DIMENSIONS ARE IN MILLIMETERS.

NOTE: ALL DIMENSIONS CAN BE ASSUMED AS ORIGINATING FROM SHARP CORNERS, UNLESS NOTED OTHERWISE.

= CRITICAL DIMENSION

* = FLATNESS & SQUARENESS CRITICAL

The information, design or data shown on this document or electronic media is the exclusive property of Veka Inc. It is considered confidential and proprietary and is made available for limited use only. Its use or reproduction without the expressed written consent of Veka Inc. is prohibited.

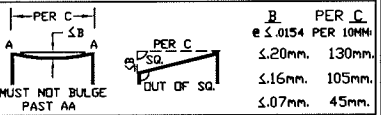

NO.	REVISIONS	DATE
1	26.1 TO 23, 22.85 TO 25.95	24 SEPT 2010 (TJF)
REVISIONS		
DATE		
WEIGHT: 0.788 lb/ft AREA: 805.582mm ²		
UNSPECIFIED WALL THICKNESS OUTER 1.65mm INNER 1.3mm		
UNSPECIFIED RADII 0.5mm UNSPECIFIED TOLERANCE ±0.2mm		




VEKA INC.
100 VEKA DRIVE
FOMBELL, PA 16123


DRAWN: SMB	DATE: 7 JULY 2010	SCALE: AS NOTED
CHK'D:	DATE:	APP'VD:
TITLE SINGLE SLIDER FRAME		DWG. # SS9301

Test sample complies with these details.
Deviations are noted.

Report# A7804
Date 2/18/11 Tech JDC

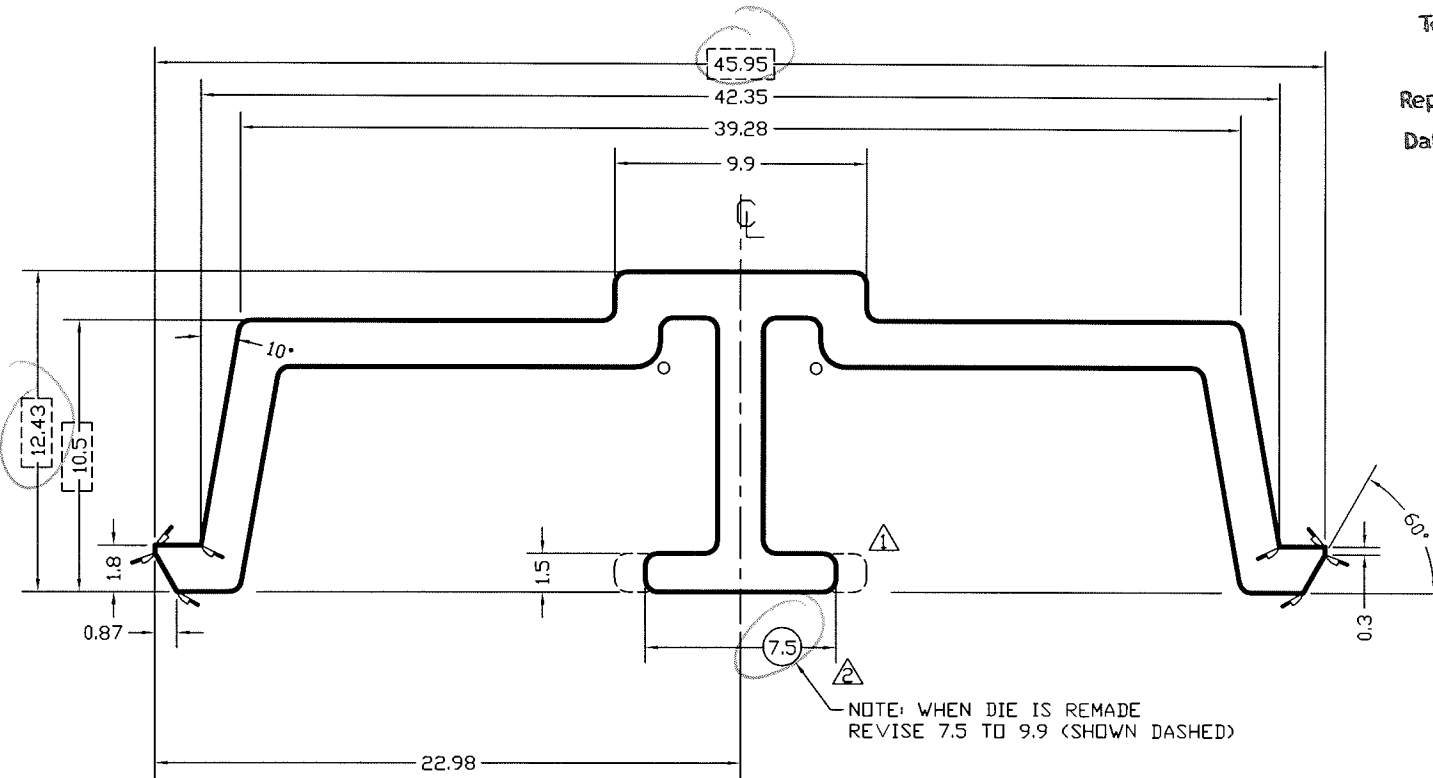

FILLETS:	
○	=R1.0
↖	=SHARP

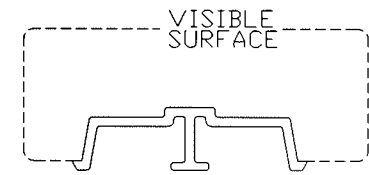

5X SCALE

NOTE: PART IS SYMMETRICAL ABOUT ϕ


FULL SCALE

DIMENSIONS ARE IN MILLIMETERS.


★ = DIMENSION TAKEN FROM FURTHEST POINT ON RADIUS

MATERIAL: RIGID PVC

NOTE: ALL DIMENSIONS CAN BE ASSUMED AS ORIGINATING FROM SHARP CORNERS, UNLESS NOTED OTHERWISE.

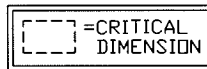

* = FLATNESS & SQUARENESS CRITICAL

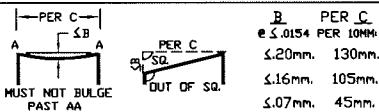

The information, design or data shown on this document or electronic media is the exclusive property of Veka Inc. It is considered confidential and proprietary and is made available for limited use only. Its use or reproduction without the expressed written consent of Veka Inc. is prohibited.

2	9.9 TO 7.5, ADJUST AREA & WEIGHT PER REV	27 SEPT 2010 TJF
1	4.2 TO 9.9, ADJUST AREA & WEIGHT PER REV	19 AUG 2010 TJF
REVISIONS		DATE
WEIGHT: 0.139 lb/ft		AREA: 141.929 mm ²
UNSPECIFIED WALL THICKNESS		1.8mm
UNSPECIFIED RADII		0.5mm
UNSPECIFIED TOLERANCE		±0.2mm



VEKA INC.
100 VEKA DRIVE
FOMBELL, PA 16123







DRAWN: SMB	DATE: 16 JULY 10	SCALE: AS NOTED
CHK'D:	DATE:	APP'VD:
TITLE ROLLER TRACK		DWG. # SS9308

Test sample complies with these details.
Deviations are noted.

Report# A7804
Date 2/17/11 Tech Jen

FILLETS:

- ▲ = R0.25
- = R1.0

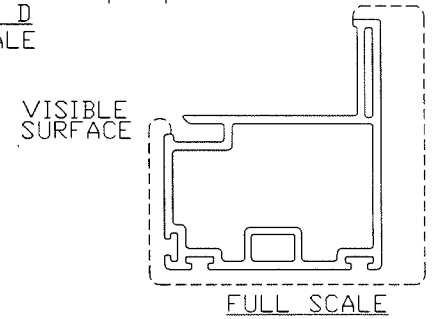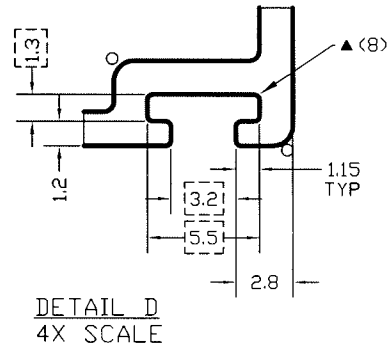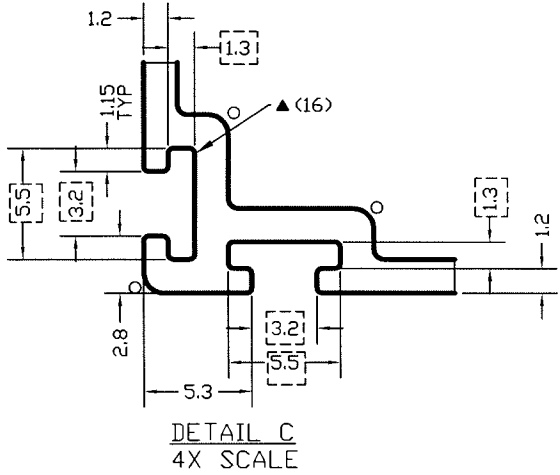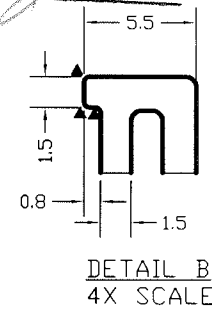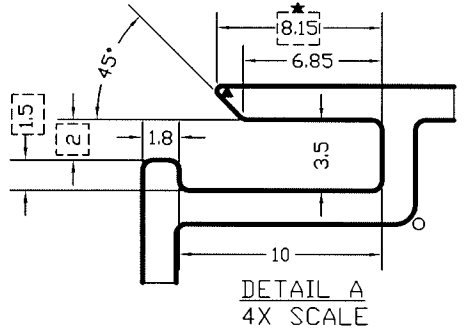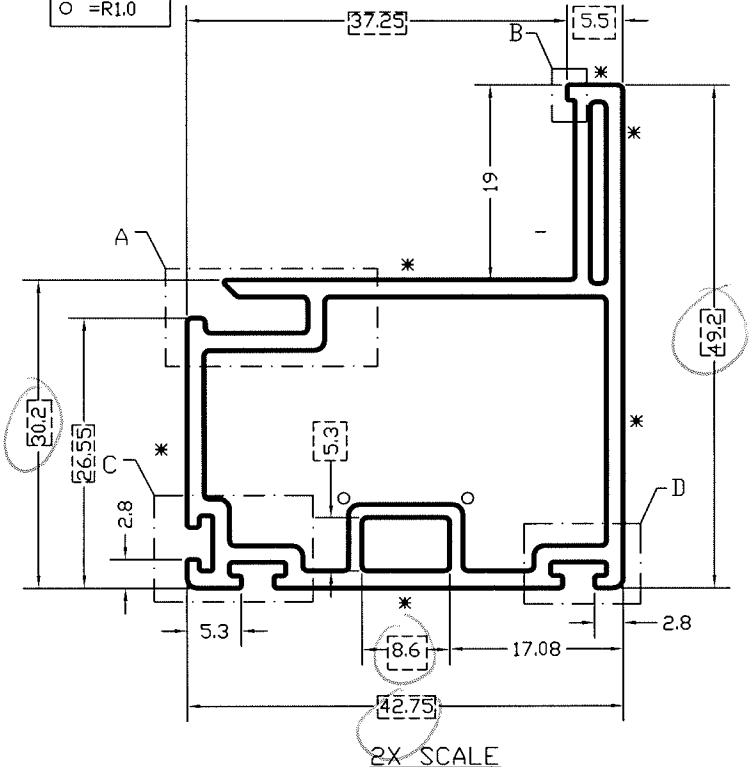


★ = DIMENSION TAKEN FROM FURTHEST POINT ON RADIUS

MATERIAL: RIGID PVC

DIMENSIONS ARE IN MILLIMETERS.

NOTE: ALL DIMENSIONS CAN BE ASSUMED AS ORIGINATING FROM SHARP CORNERS, UNLESS NOTED OTHERWISE.

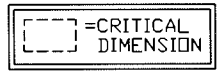

* = FLATNESS & SQUARENESS CRITICAL

PER C	PER C	PER C
PER C	PER C	PER C
PER C	PER C	PER C
PER C	PER C	PER C

MUST NOT BULGE PAST AA

OUT OF SQ.

REVISIONS	DATE
WEIGHT: 0.349 lb/ft	AREA: 356.481mm ²
UNSPECIFIED WALL THICKNESS OUTER 1.65mm	INNER 1.3mm
UNSPECIFIED RADII 0.5mm	UNSPECIFIED TOLERANCE ±0.2mm




VEKA INC.
100 VEKA DRIVE
FOMBELL, PA 16123

DRAWN: BJF	DATE: 28 JUN 10	SCALE: AS NOTED
CHK'D:	DATE:	APP'VD:
TITLE COMMON SASH	DWG. # SE9345	

The information, design or data shown on this document or electronic media is the exclusive property of Veka Inc. It is considered confidential and proprietary and is made available for limited use only. Its use or reproduction without the expressed written consent of Veka Inc. is prohibited.

Test sample complies with these details.
Deviations are noted.

Report# A7802
Date 2/17/11 Tech John

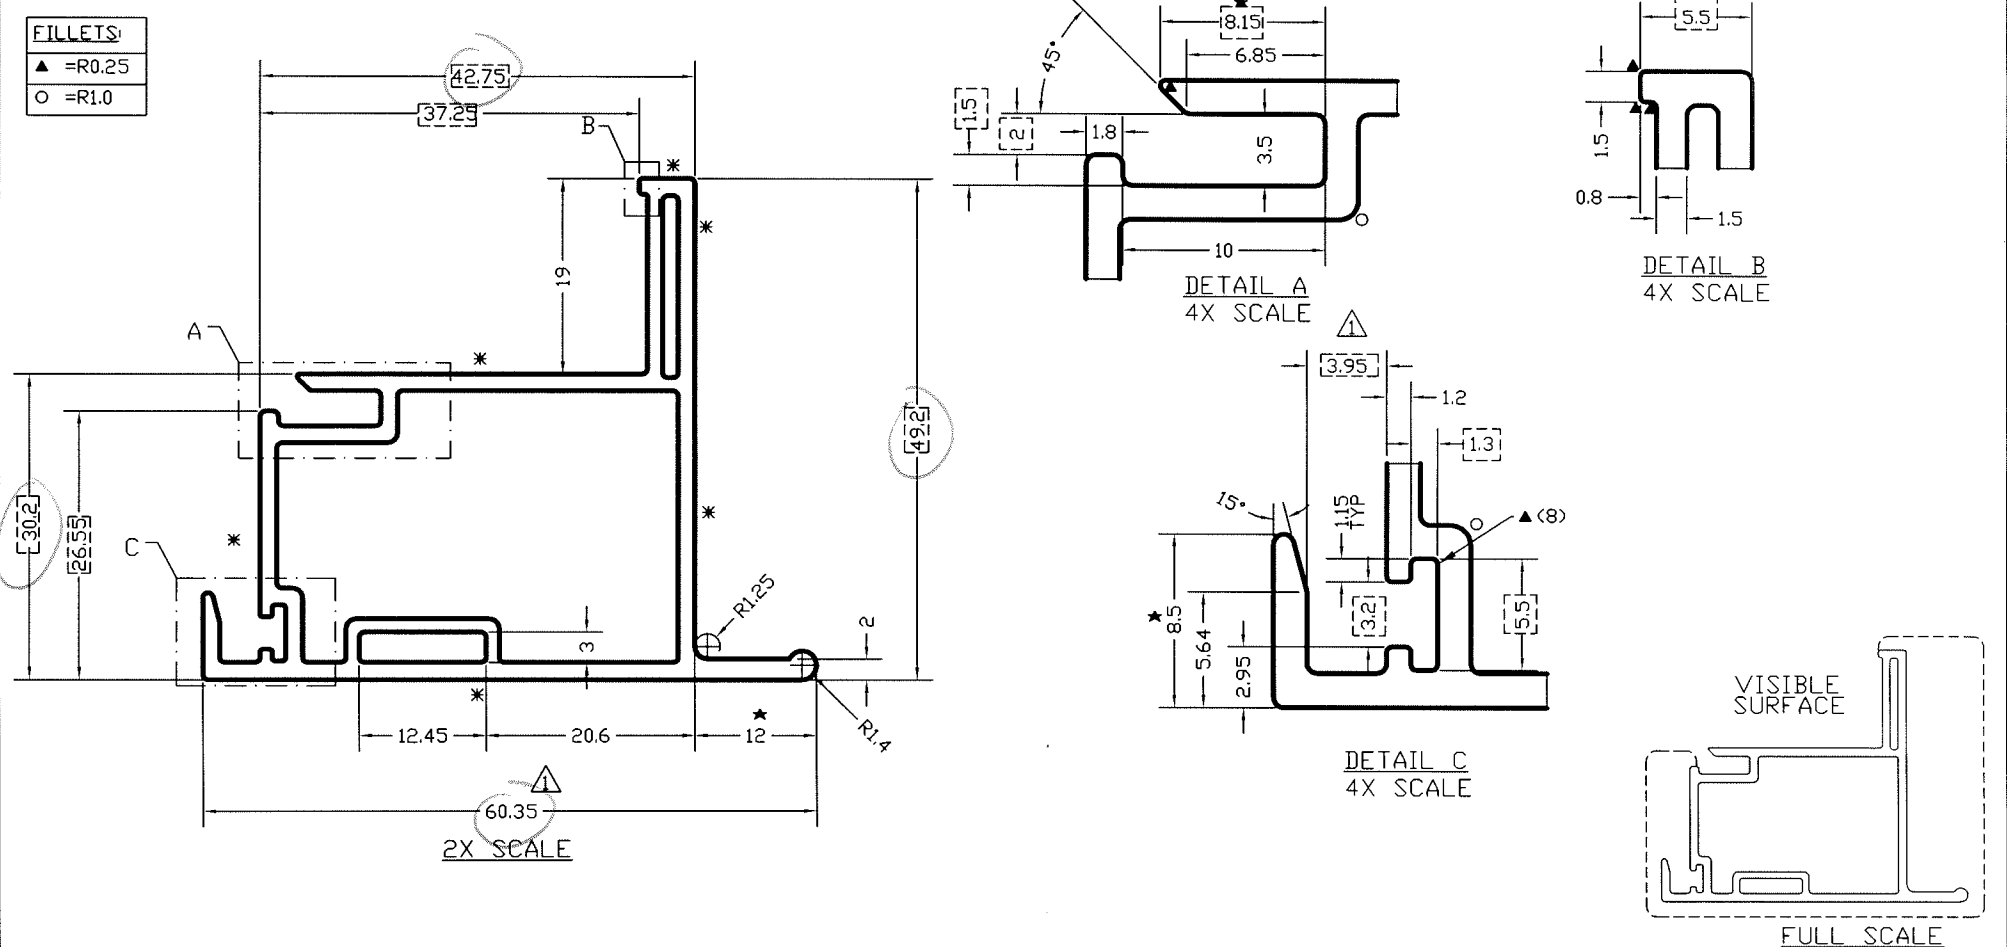

DIMENSIONS ARE IN MILLIMETERS.

★ = DIMENSION TAKEN FROM FURTHEST POINT ON RADIUS


MATERIAL: RIGID PVC

NOTE: ALL DIMENSIONS CAN BE ASSUMED AS ORIGINATING FROM SHARP CORNERS, UNLESS NOTED OTHERWISE.



* = FLATNESS & SQUARENESS CRITICAL

The information, design or data shown on this document or electronic media is the exclusive property of Veka Inc. It is considered confidential and proprietary and is made available for limited use only. Its use or reproduction without the expressed written consent of Veka Inc. is prohibited.

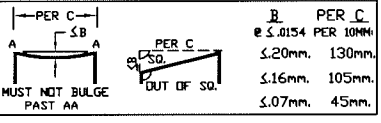

REV.	REVISIONS	DATE
1.	REV. INTERLOCK WIDTH	19 NOV 10 JMN
REVISIONS		
WEIGHT: 0.379 lb/ft AREA: 387.626 mm ²		
UNSPECIFIED WALL THICKNESS OUTER 1.65mm INNER 1.3mm		
UNSPECIFIED RADII 0.5mm UNSPECIFIED TOLERANCE ±0.2mm		



VEKA INC.
100 VEKA DRIVE
FOMBELL, PA 16123






DRAWN: BJF	DATE: 06 JUL 10	SCALE: AS NOTED
CHK'D:	DATE:	APPVD:
TITLE LIFT RAIL		DWG. # SE9346




Test sample complies with these details.
Deviations are noted.

Report# A7806
Date 2/17/11 Tech Jan

FILLETS:
▲ =R0.25
○ =R1.0

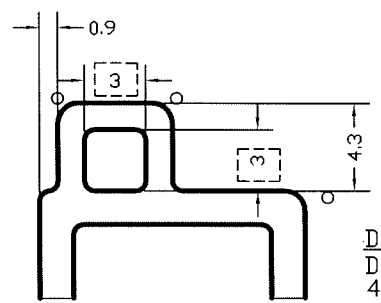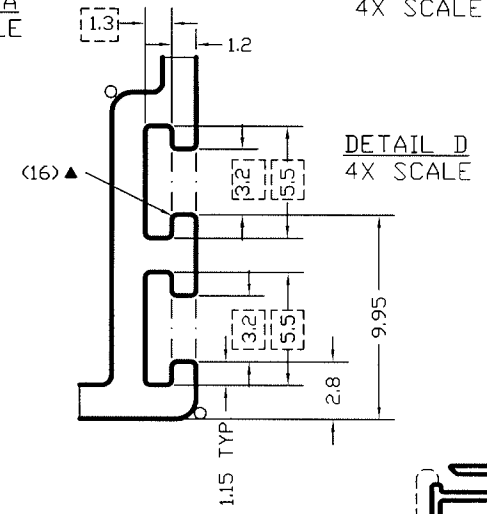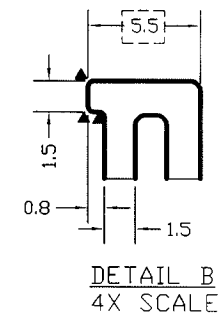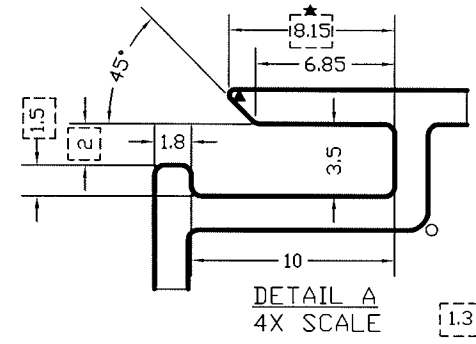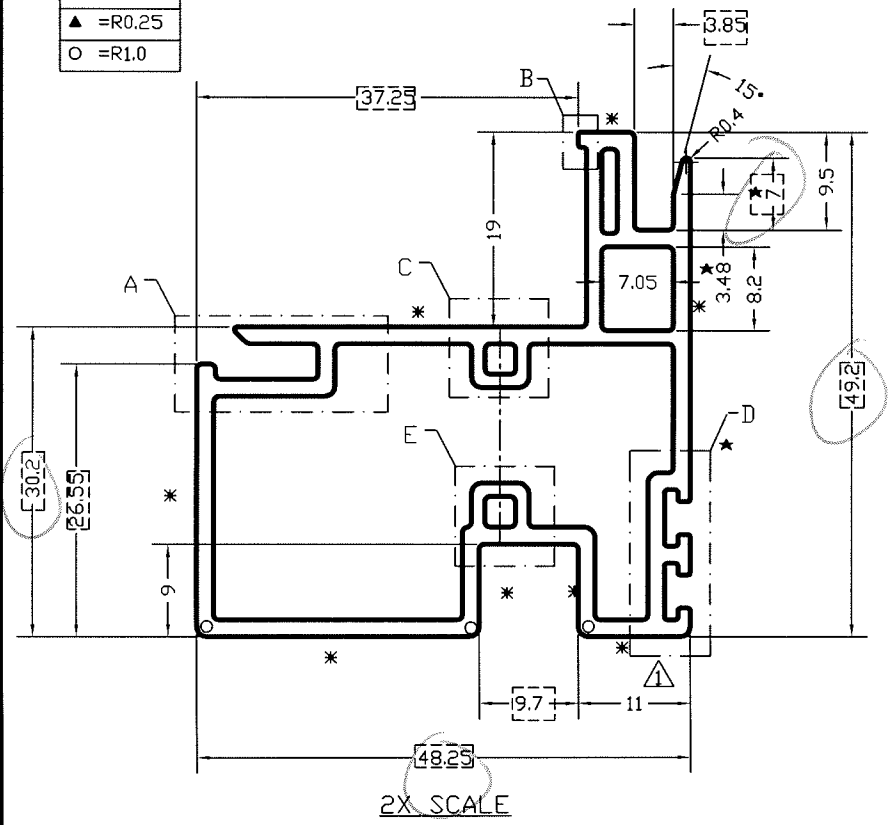

DETAIL C SIMILAR 4X SCALE

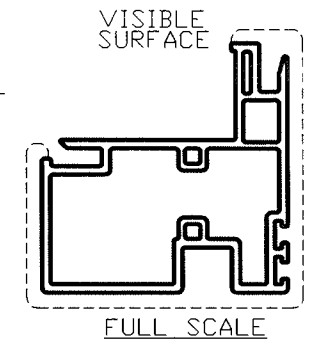


DIMENSIONS ARE IN MILLIMETERS.

★ = DIMENSION TAKEN FROM FURTHEST POINT ON RADIUS

MATERIAL: RIGID PVC

NOTE: ALL DIMENSIONS CAN BE ASSUMED AS ORIGINATING FROM SHARP CORNERS, UNLESS NOTED OTHERWISE.

[] = CRITICAL DIMENSION

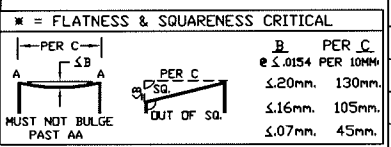


The information, design or data shown on this document or electronic media is the exclusive property of Veka Inc. It is considered confidential and proprietary and is made available for limited use only. Its use or reproduction without the expressed written consent of Veka Inc. is prohibited.

NO.	REVISIONS	DATE
1	WAS 10.1; NOW 11	
WEIGHT: 0.409 lb/ft AREA: 418.346 mm ²		
UNSPECIFIED WALL THICKNESS OUTER 1.65mm INNER 1.3mm		
UNSPECIFIED RADII 0.5mm UNSPECIFIED TOLERANCE ±0.2mm		



VEKA INC.
100 VEKA DRIVE
FOMBELL, PA 16123

DRAWN: BJF	DATE: 24 JUN 10	SCALE: AS NOTED
CHK'D:	DATE:	APPVD:
TITLE FIXED MEETING RAIL		DWG. # SH9304

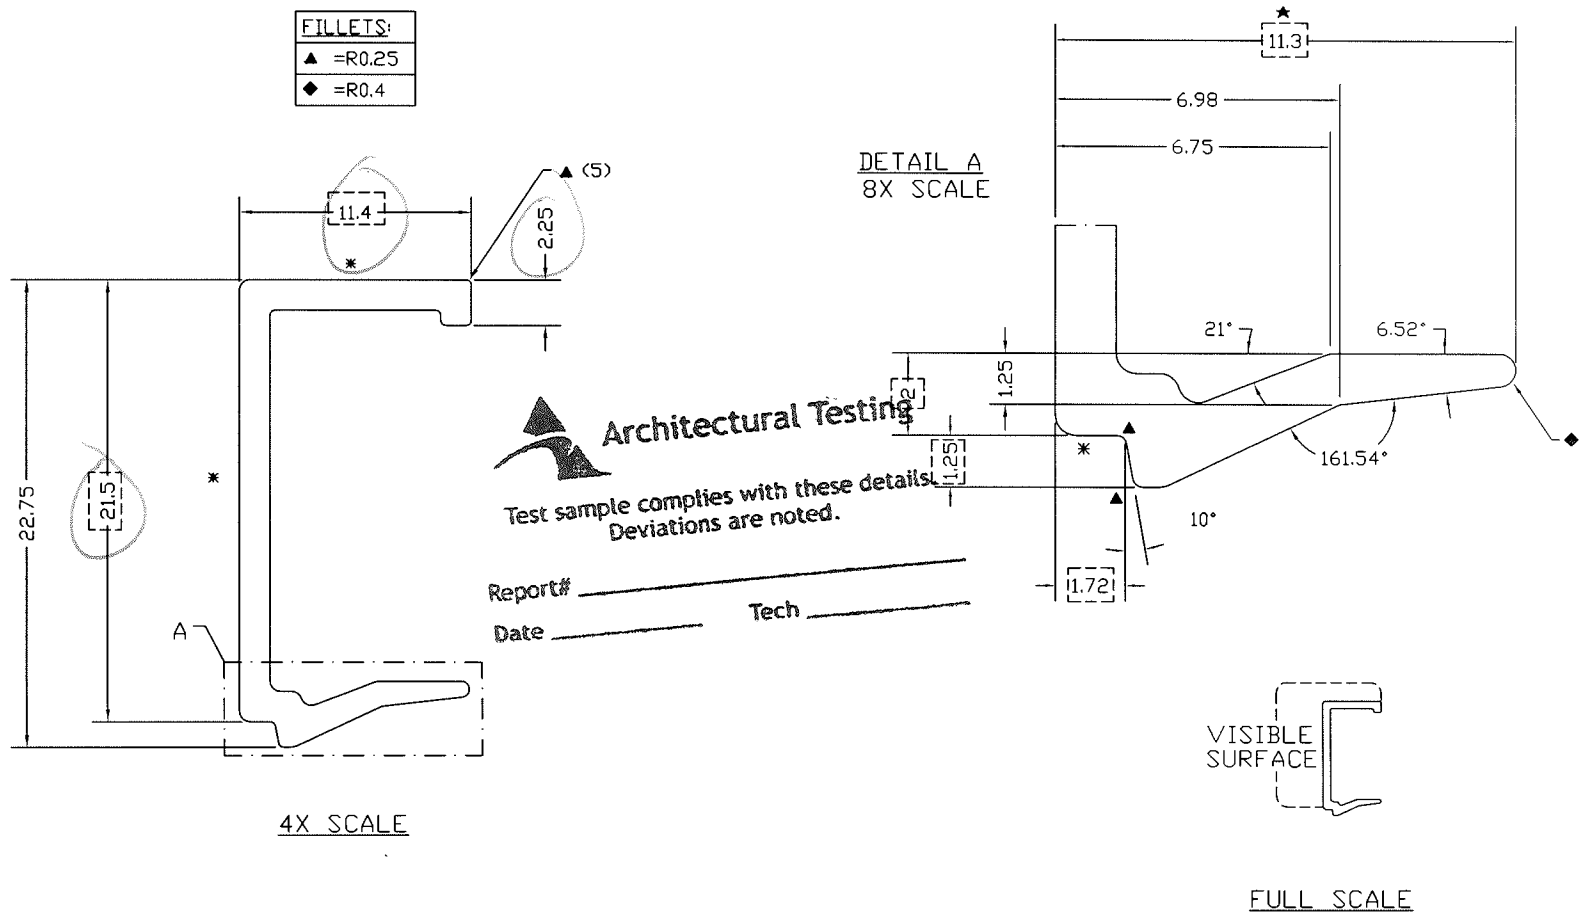

FILLETS:	
▲	=R0.25
◆	=R0.4


DETAIL A
8X SCALE

Architectural Testing

Test sample complies with these details.
Deviations are noted.

Report# _____
Date _____ Tech _____

4X SCALE

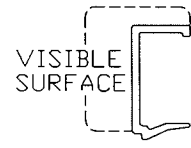


FULL SCALE

★ = DIMENSION TAKEN FROM FURTHEST POINT ON RADIUS

MATERIAL: RIGID PVC

DIMENSIONS ARE IN MILLIMETERS.

NOTE: ALL DIMENSIONS CAN BE ASSUMED AS ORIGINATING FROM SHARP CORNERS, UNLESS NOTED OTHERWISE.

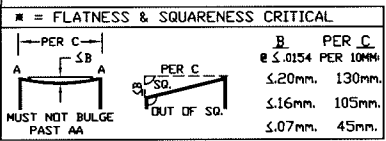

The information, design or data shown on this document or electronic media is the exclusive property of Veka Inc. It is considered confidential and proprietary and is made available for limited use only. Its use or reproduction without the expressed written consent of Veka Inc. is prohibited.

REVISIONS	DATE

WEIGHT: 0.061 lb/ft AREA: 62.19mm²

UNSPECIFIED WALL THICKNESS OUTER 1.50mm INNER N/A

UNSPECIFIED RADII 0.5mm UNSPECIFIED TOLERANCE ±0.2mm




VEKA INC.
100 VEKA DRIVE
FOMBELL, PA 16123

DRAWN: B.J.F.	DATE: 19 SEPT 05	SCALE: AS NOTED
CHK'D:	DATE:	APP'VD:
TITLE 3/4' GLAZING BEAD		DWG. # BV137



Test sample complies with these details.
Deviations are noted.

Report# A7806
Date 2/17/11 Tech JMN

CLEARANCES
1.5X SCALE

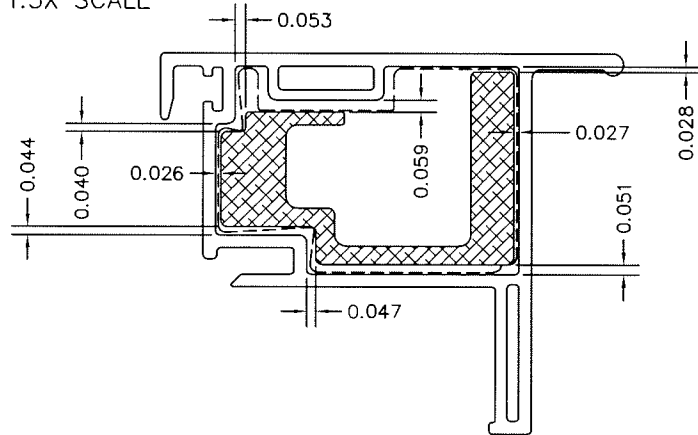


RF SE9346 AOM

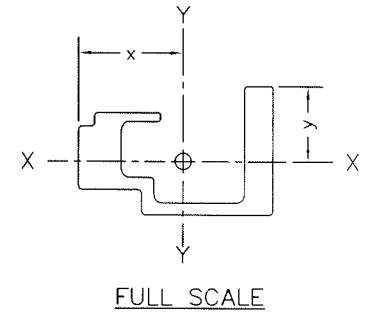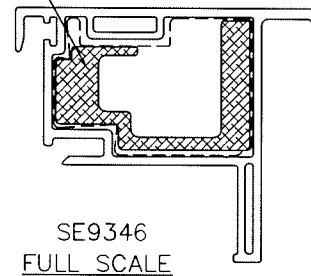

FILLETS:

- = R0.015
- △ = R0.020
- ◇ = R0.030
- = R0.060

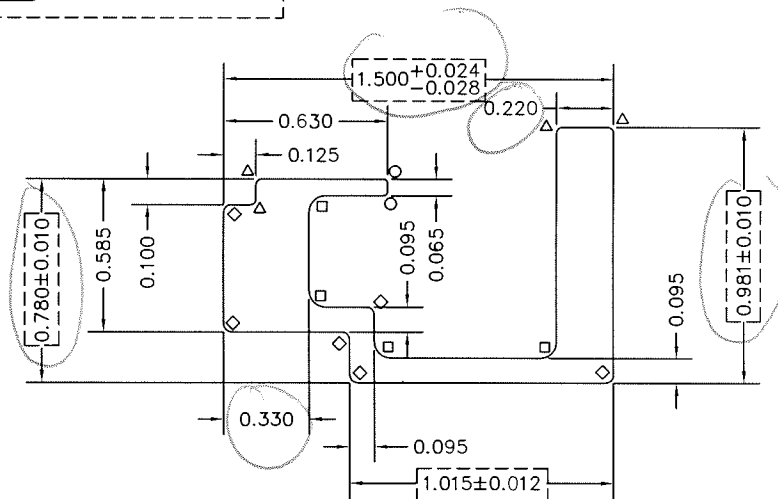

RF SE9346 AO M
2X SCALE

PROFILE PROPERTIES

MATERIAL: 6063-T6

AREA: 0.5266 IN.²

WEIGHT: 0.632 #/Ft.

MOMENTS OF INERTIA:

I_{xx}: 0.03767 IN.⁴

I_{yy}: 0.1591 IN.⁴

EXTREME FIBER DISTANCE:

x: 0.8052 IN.

y: 0.5691 IN.

SECTION MODULI:

S_{xx}: 0.06620 IN.³

S_{yy}: 0.1976 IN.³

NOTE: DIMENSIONS ARE IN INCHES

STANDARD COMMERCIAL TOLERANCES FOR
EXTRUDED ROD BAR & SHAPES APPLY
UNLESS SPECIFICALLY SHOWN OTHERWISE

The information, design or data shown on
this document or electronic media is the
exclusive property of Veka Inc. It is
considered confidential and proprietary and
is made available for limited use only. Its
use or reproduction without the expressed
written consent of Veka Inc. is prohibited.

Q.A. NOTE:

- = CRITICAL DIMENSION

REVISIONS	DATE




VEKA INC.
100 VEKA DRIVE
FOMBELL, PA 16123


DRAWN: BJF	DATE: 12 OCT 10	SCALE: AS NOT
CHK'D: JMN	DATE: 21 OCT 10	APP'VD: JJS
TITLE: SE9346 (DH93WW) REINFORCING LC CLASS		DWG. # RF SE9346

Test sample complies with these details.
Deviations are noted.


Report# A7802
Date 2/17/11 Tech [Signature]

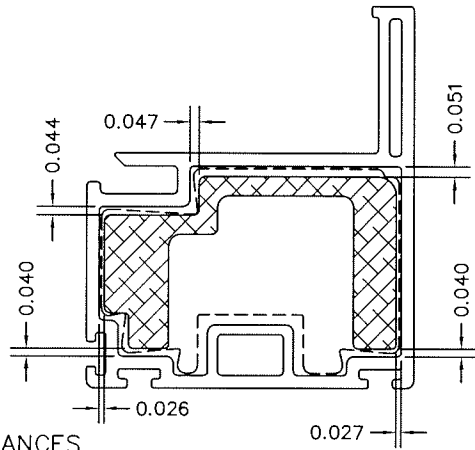

CLEARANCES
1.5X SCALE

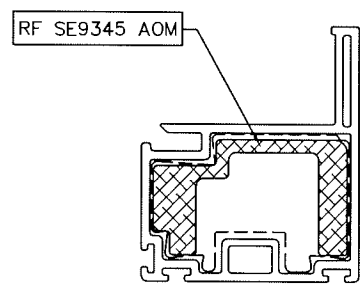


SE9345
FULL SCALE

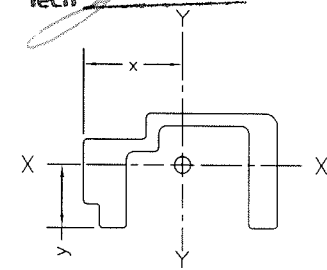

FULL SCALE

FILLETS:	
○	= R0.020
□	= R0.015
△	= R0.030
◇	= R0.060

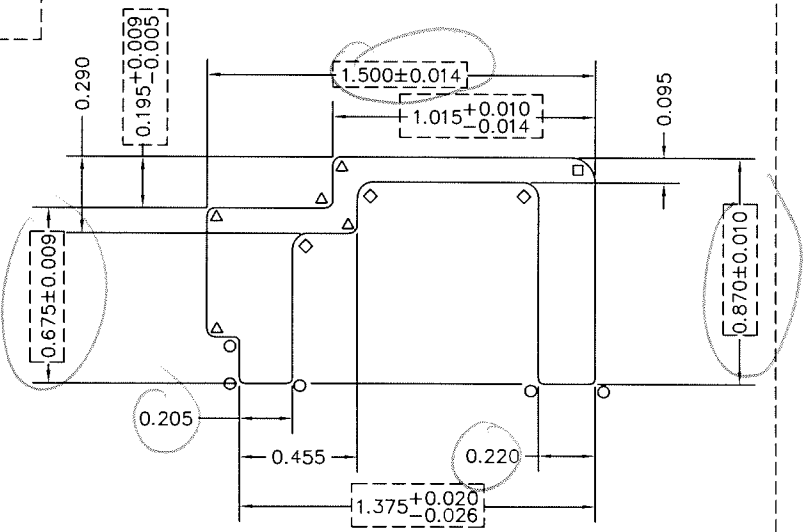

RF SE9345 AO M
2X SCALE

PROFILE PROPERTIES	
MATERIAL:	6063-T5
AREA:	0.4999 IN. ²
WEIGHT:	0.600 #/Ft.
MOMENTS OF INERTIA:	
I _{xx} :	0.0317 IN. ⁴
I _{yy} :	0.1536 IN. ⁴
EXTREME FIBER DISTANCE:	
x:	0.765 IN.
y:	0.480 IN.
SECTION MODULI:	
S _{xx} :	0.0661 IN. ³
S _{yy} :	0.2008 IN. ³

NOTE: DIMENSIONS ARE IN INCHES

STANDARD COMMERCIAL TOLERANCES FOR
EXTRUDED ROD BAR & SHAPES APPLY
UNLESS SPECIFICALLY SHOWN OTHERWISE

The information, design or data shown on
this document or electronic media is the
exclusive property of Veko Inc. It is
considered confidential and proprietary and
is made available for limited use only. Its
use or reproduction without the expressed
written consent of Veko Inc. is prohibited.

Q.A. NOTE:
[] = CRITICAL
[] = DIMENSION

REVISIONS	DATE



VEKA INC.
100 VEKA DRIVE
FOMBELL, PA 16123

DRAWN: BJF	DATE: 12 OCT 10	SCALE: AS NO
CHK'D: JMN	DATE: 21 OCT 10	APP'VD: JJS
TITLE SE9345 REINFORCING LC CLASS		DWG. # RF SE9345



Test sample complies with these details.
Deviations are noted.

Report# A7802


Date 2/17/11

Tech Jan

CLEARANCES
1.5X SCALE

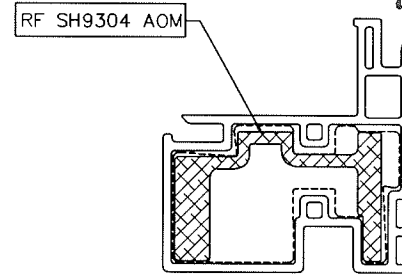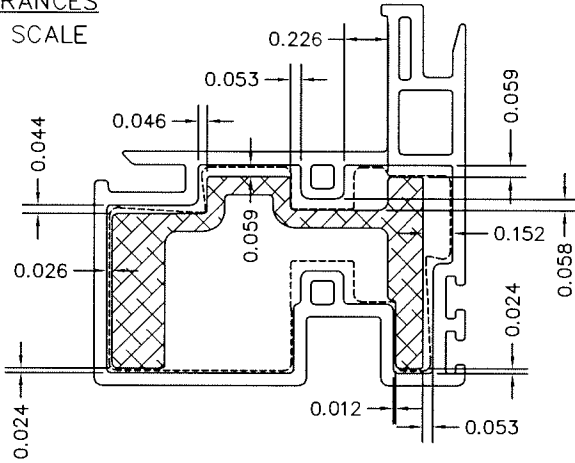


SH9304
FULL SCALE

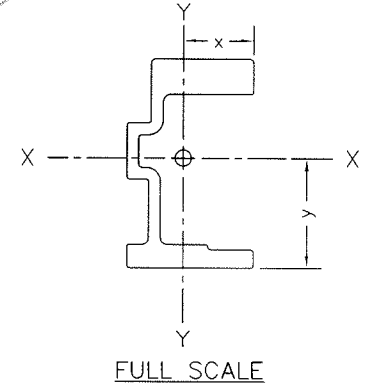

FULL SCALE

FILLETS:	
○	= R0.015
△	= R0.020
●	= R0.025
▲	= R0.050
◇	= R0.030
□	= R0.060
◆	= R0.110

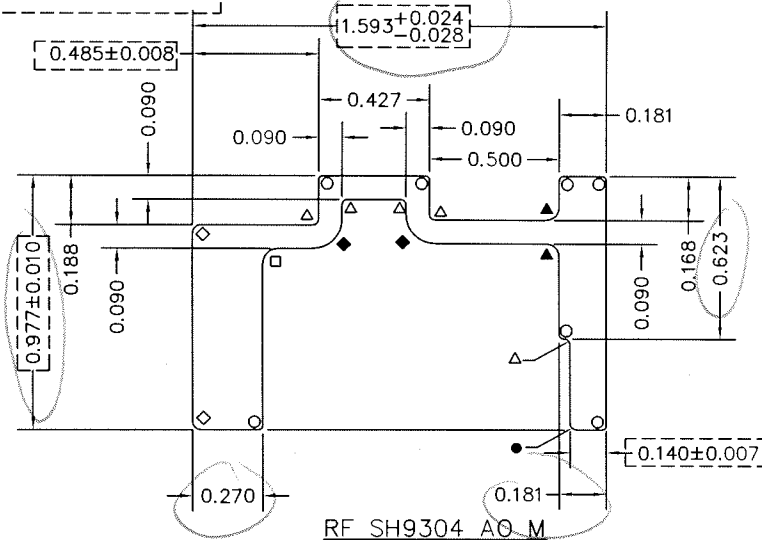

RF SH9304 AOM
2X SCALE

PROFILE PROPERTIES

MATERIAL: 6063-T6

AREA: 0.5062 IN.²

WEIGHT: 0.607 #/Ft.

MOMENTS OF INERTIA:

I_{xx}: 0.18875 IN.⁴

I_{yy}: 0.03899 IN.⁴

EXTREME FIBER DISTANCE:

x: 0.5438 IN.

y: 0.840 IN.

SECTION MODULI:

S_{xx}: 0.2248 IN.³

S_{yy}: 0.07163 IN.³

NOTE: DIMENSIONS ARE IN INCHES

STANDARD COMMERCIAL TOLERANCES FOR
EXTRUDED ROD BAR & SHAPES APPLY
UNLESS SPECIFICALLY SHOWN OTHERWISE

The information, design or data shown on
this document or electronic media is the
exclusive property of Veka Inc. It is
considered confidential and proprietary and
is made available for limited use only. Its
use or reproduction without the expressed
written consent of Veka Inc. is prohibited.

Q.A. NOTE:
[] = CRITICAL
[] = DIMENSION

REVISIONS	DATE



VEKA INC.
100 VEKA DRIVE
FOMBELL, PA 16123

DRAWN: BJF	DATE: 12 OCT 10	SCALE: AS NOTED
CHK'D: JMN	DATE: 21 OCT 2010	APP'D: JJS
TITLE: SH9304 REINFORCING LC CLASS		DWG. # RF SH9304